

NO. STREET

DATE INST.


MAKE:

SIZE

62 CENTER SQ

10-5-07

N. MAIN ST.

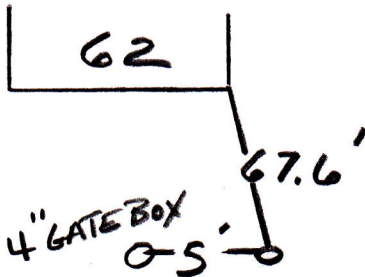

1' COPPER
WEBSTER
BANK

→ TO TOWN HALL PARKING