

NO. STREET


DATE INST.

MAKE:

SIZE

252 CHESTNUT ST.

5-19-10

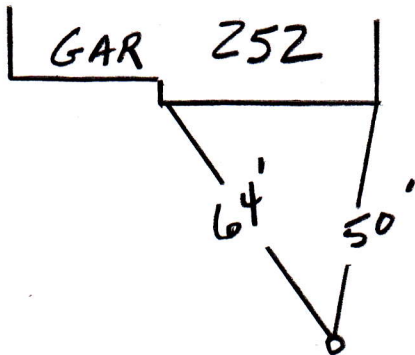

1" COPPER