


NO. STREET

DATE INST.

MAKE:

SIZE

37 FENWAY LN.

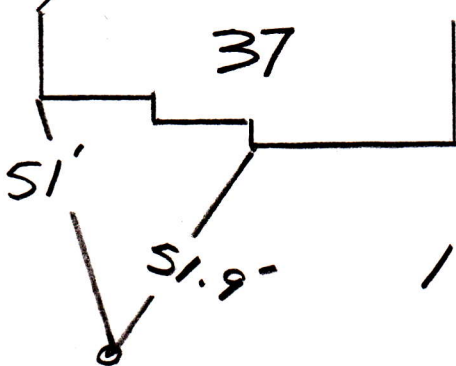

1" COPPER