

NO. STREET


DATE INST.

MAKE:

SIZE

16 FERNWOOD DRIVE

10-18-11

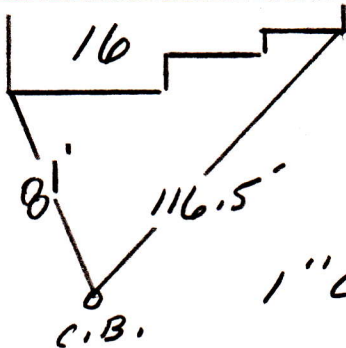

1" COPPER