

NO. STREET


DATE INST.

MAKE:

SIZE

164 GATES AVE

5-7-13

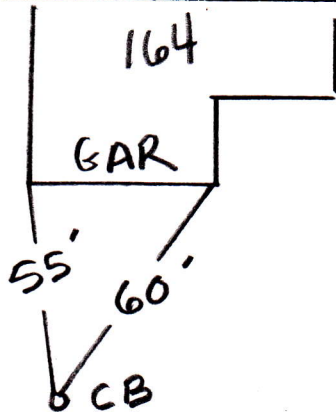

1" COPPER