

NO. STREET


DATE INST.

MAKE:

SIZE 1"

18 HOLLAND DRIVE

11/10

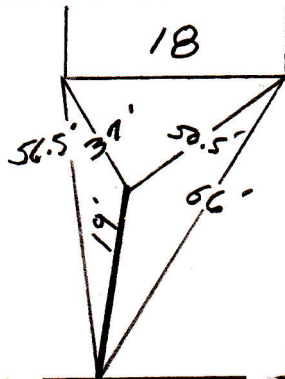

1" CORP

8" C900