

NO. STREET


DATE INST.

MAKE:

SIZE

30 HOLLAND DRIVE

11/10

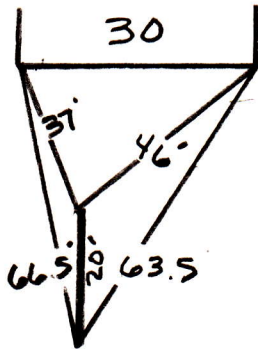

8" C900

1" CORP-4' DEEP