

NO. STREET

DATE INST.


MAKE:

SIZE

1"

37 HOLLAND DRIVE

10/10

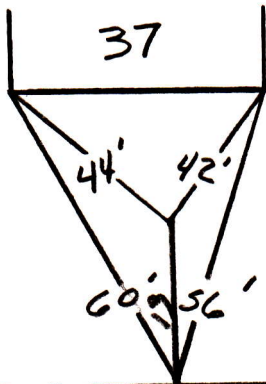

8" C900