

NO. STREET


DATE INST.

MAKE:

SIZE 1"

53 HOLLAND DRIVE

10/10

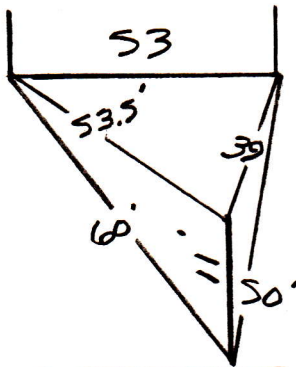

1" CORP

8" C900