

NO. STREET


DATE INST.

MAKE:

SIZE

94 MAPLE ST.

6-20-12

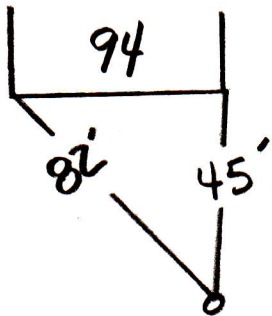

1 1/2" COPPER