

NO. STREET


DATE INST.

MAKE:

SIZE

112 MAPLESHADE AVE

11-24-09

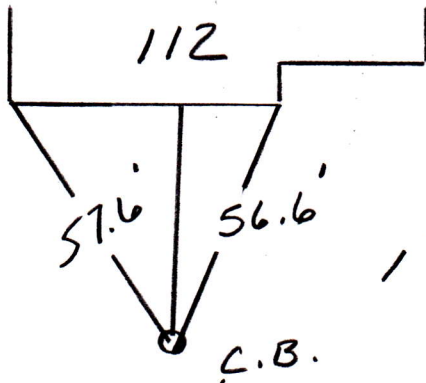

1" COPPER