

NO. STREET


DATE INST.

MAKE:

SIZE

8 NORTH STREET

9-2-11

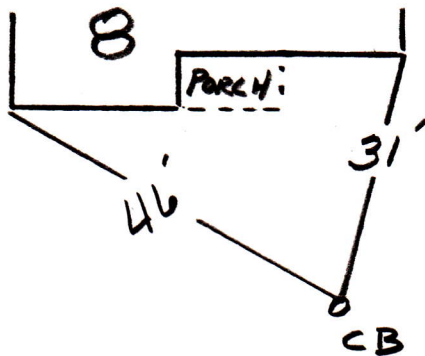

1" COPPER