

NO. STREET

LOT 1-R

DATE INST.

MAKE:


SIZE

15 NOTTINGHAM DRIVE

3/28/02

BADGER

1"

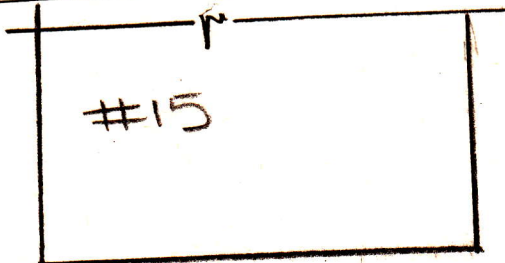

76

hyd