



NO. STREET

DATE INST.

MAKE:

SIZE

117 NOTTINGHAM DRIVE

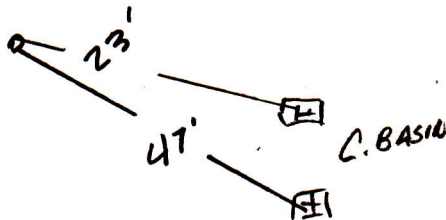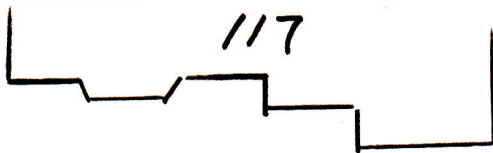

25'-1" COPPER