

NO. STREET


DATE INST.

MAKE:

SIZE

6 PARKER ST.

~~1-3-07~~
4-25-07

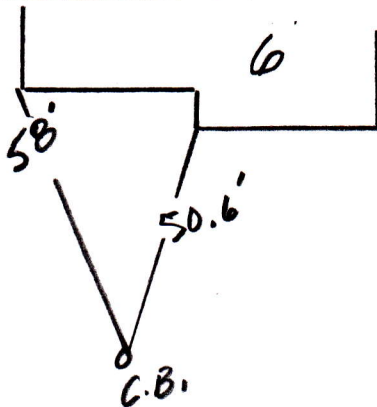

1" COPPER