

NO. STREET

DATE INST.


MAKE:

SIZE

125 PATTERSON AVE

8-13-12

PATTERSON AV.

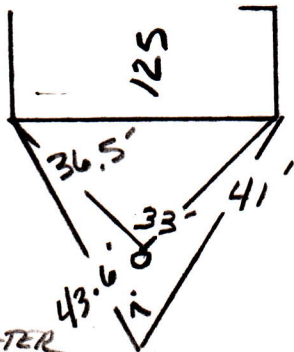

8" PVC WATER

ROBIN

ST.