

NO. STREET


DATE INST.

MAKE:

SIZE

150 PATTERSON AVE

9-11-12

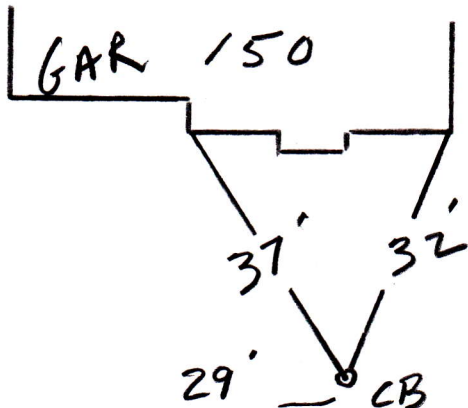

1" COPPER