

NO. STREET

3

DATE INST.

5/3/05

MAKE:


BADGER

SIZE

1"

PEACHTREE ROAD

House #3

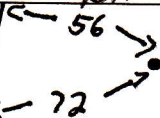

Peach tree

Parker St.