

NO. STREET


DATE INST.

MAKE:

SIZE

7 PEACHTREE ROAD

8-2-11

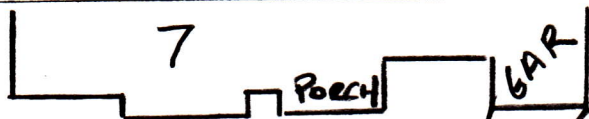

1" COPPER

47.8' 51'
C.B.