

NO. STREET

lot 6


DATE INST.

MAKE:

SIZE

34 Pembroke Terrace 4/26/01 Badger 1"

Pembroke

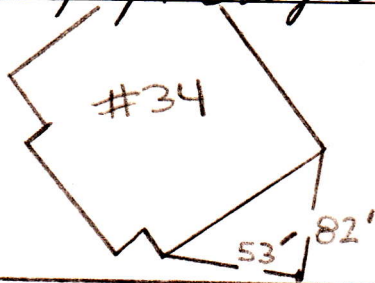

Dartmouth