

NO. STREET

Lot #1

DATE INST.

MAKE:


SIZE

53 PEMBROKE CIR.

6/16/03

BADGER

1"

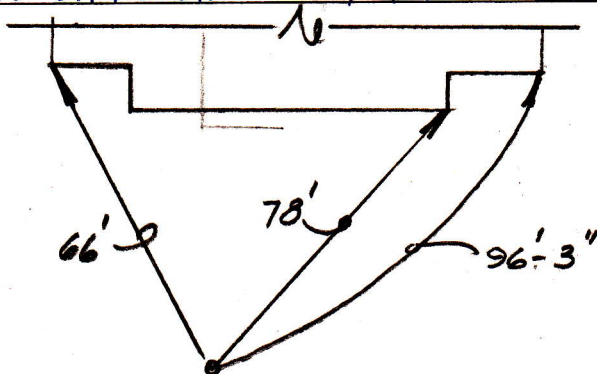

NO. STREET

DATE INST.

MAKE:

SIZE


62 PEMBROKE TER

4/22/04

BADGER

1"

House # 62

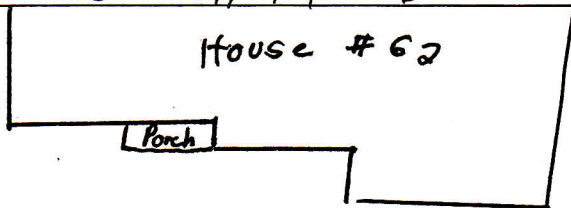

CB

28'

29'

CMH