

NO. STREET


DATE INST.

MAKE:

SIZE

87 PEMBROKE TERRACE

1-31-07

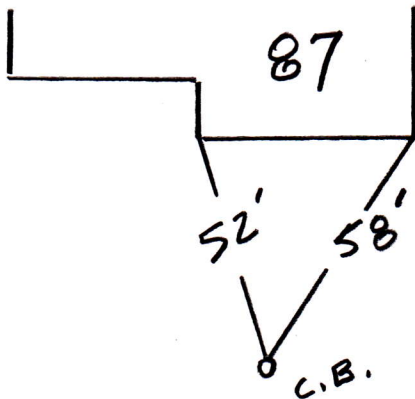

1" COPPER