

NO. STREET


DATE INST.

MAKE:

SIZE

110 PEMBROKE TERRACE

8-26-13

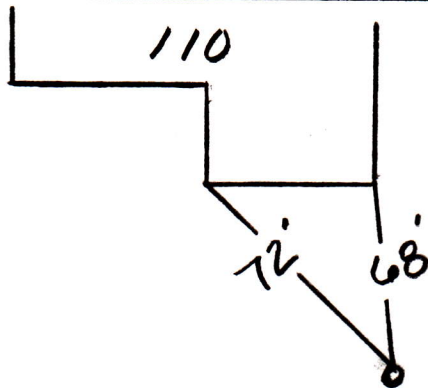

1" COPPER