

NO. STREET


DATE INST.

MAKE:

SIZE

115 PEMBROKE TR.

8-26-13

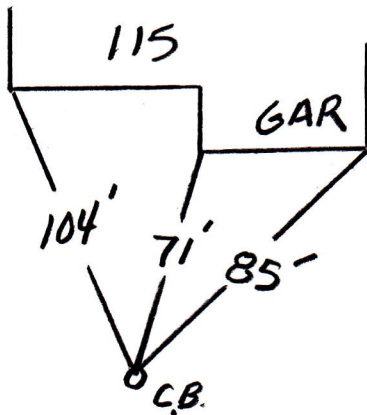

1" COPPER