

NO. STREET

(Bldg. 38)

DATE INST.

MAKE:


SIZE

317 Pinehurst Drive

4/5/02

Galper

1"

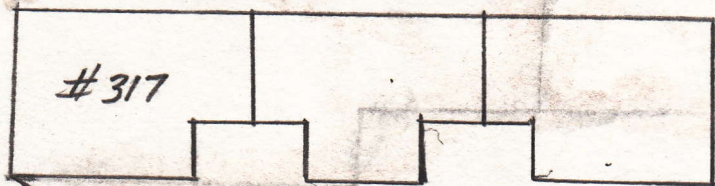

CATCH
C.B. BASIN



23'

C.B.