

NO. STREET


DATE INST.

MAKE:

SIZE

123 PROSPECT ST.

7-8-09

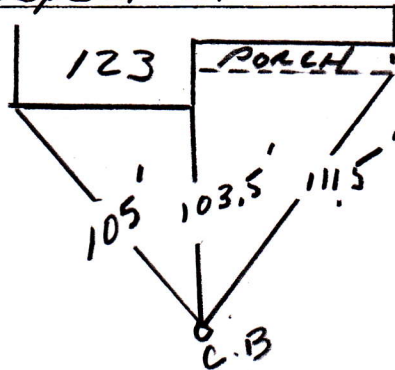

1" COPPER