


NO. STREET

DATE INST.

MAKE:

SIZE

4 RAMONA'S WAY

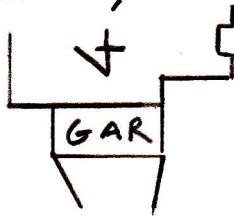

FORMERLY
474 PARKER

C.B.

PARKER ST.

RAMONA'S WAY

1" COPPER