

NO. STREET


DATE INST.

MAKE:

SIZE

17 RUFFINO ROAD

12-19-11

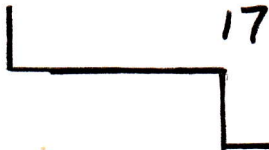

1" COPPER

CATCH BASIN 92'
50' C.B.