

NO. STREET


DATE INST.

MAKE:

SIZE

30 SAUGUS AVE.

10-13-11

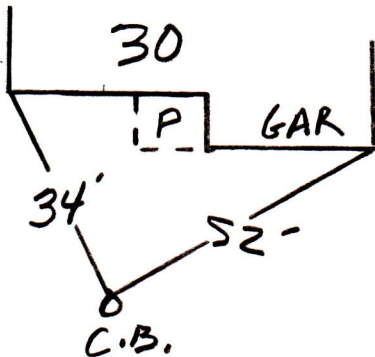

1" COPPER