

NO. STREET


DATE INST.

MAKE:

SIZE

12 SHERWOOD LN

4-28-10

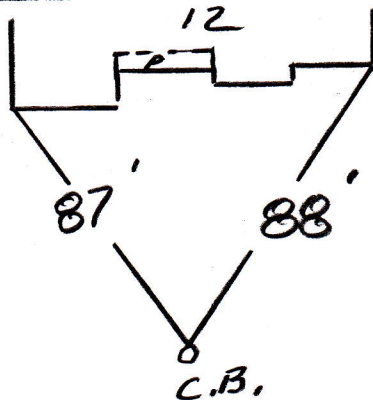

1" Copper