

NO. STREET


DATE INST.

MAKE:

SIZE

17 SHERWOOD

4-28-10

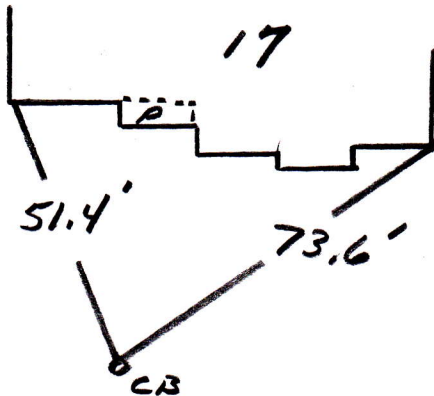

1" COPPER