

NO. STREET

DATE INST.

MAKE:


SIZE

3 SKYLINE DRIVE

7/8/03

BADGER

1"

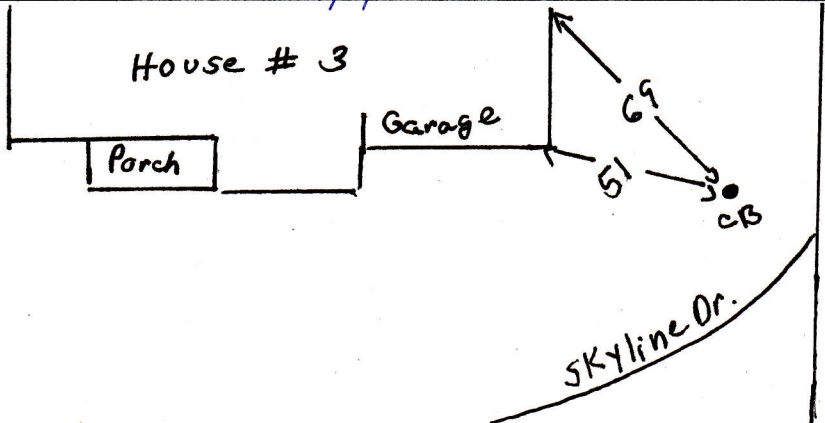

Allen St.