

NO. STREET


DATE INST.

MAKE:

SIZE

9 SOMERSVILLE ROAD

8-30-12

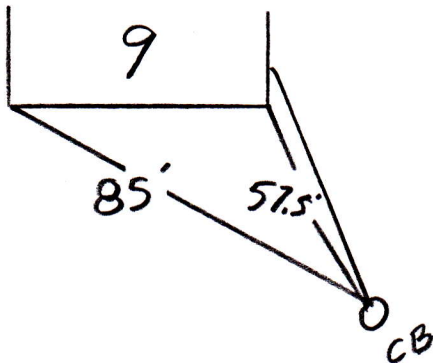

1" COPPER