


NO. STREET

DATE INST.

MAKE:

SIZE

138 VINELAND AVE.

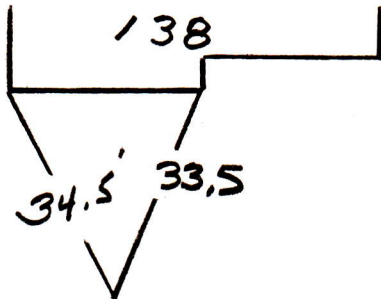

40'-1" COPPER