

NO. STREET


DATE INST.

MAKE:

SIZE

9 WISTERIA LANE

4-29-13

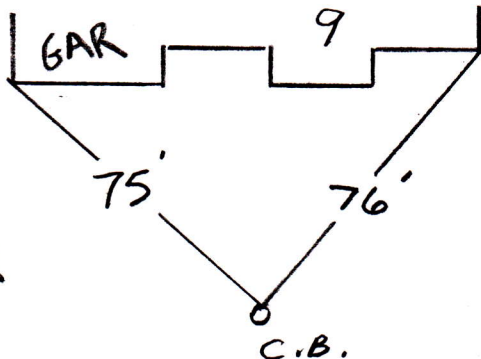

1" COPPER