



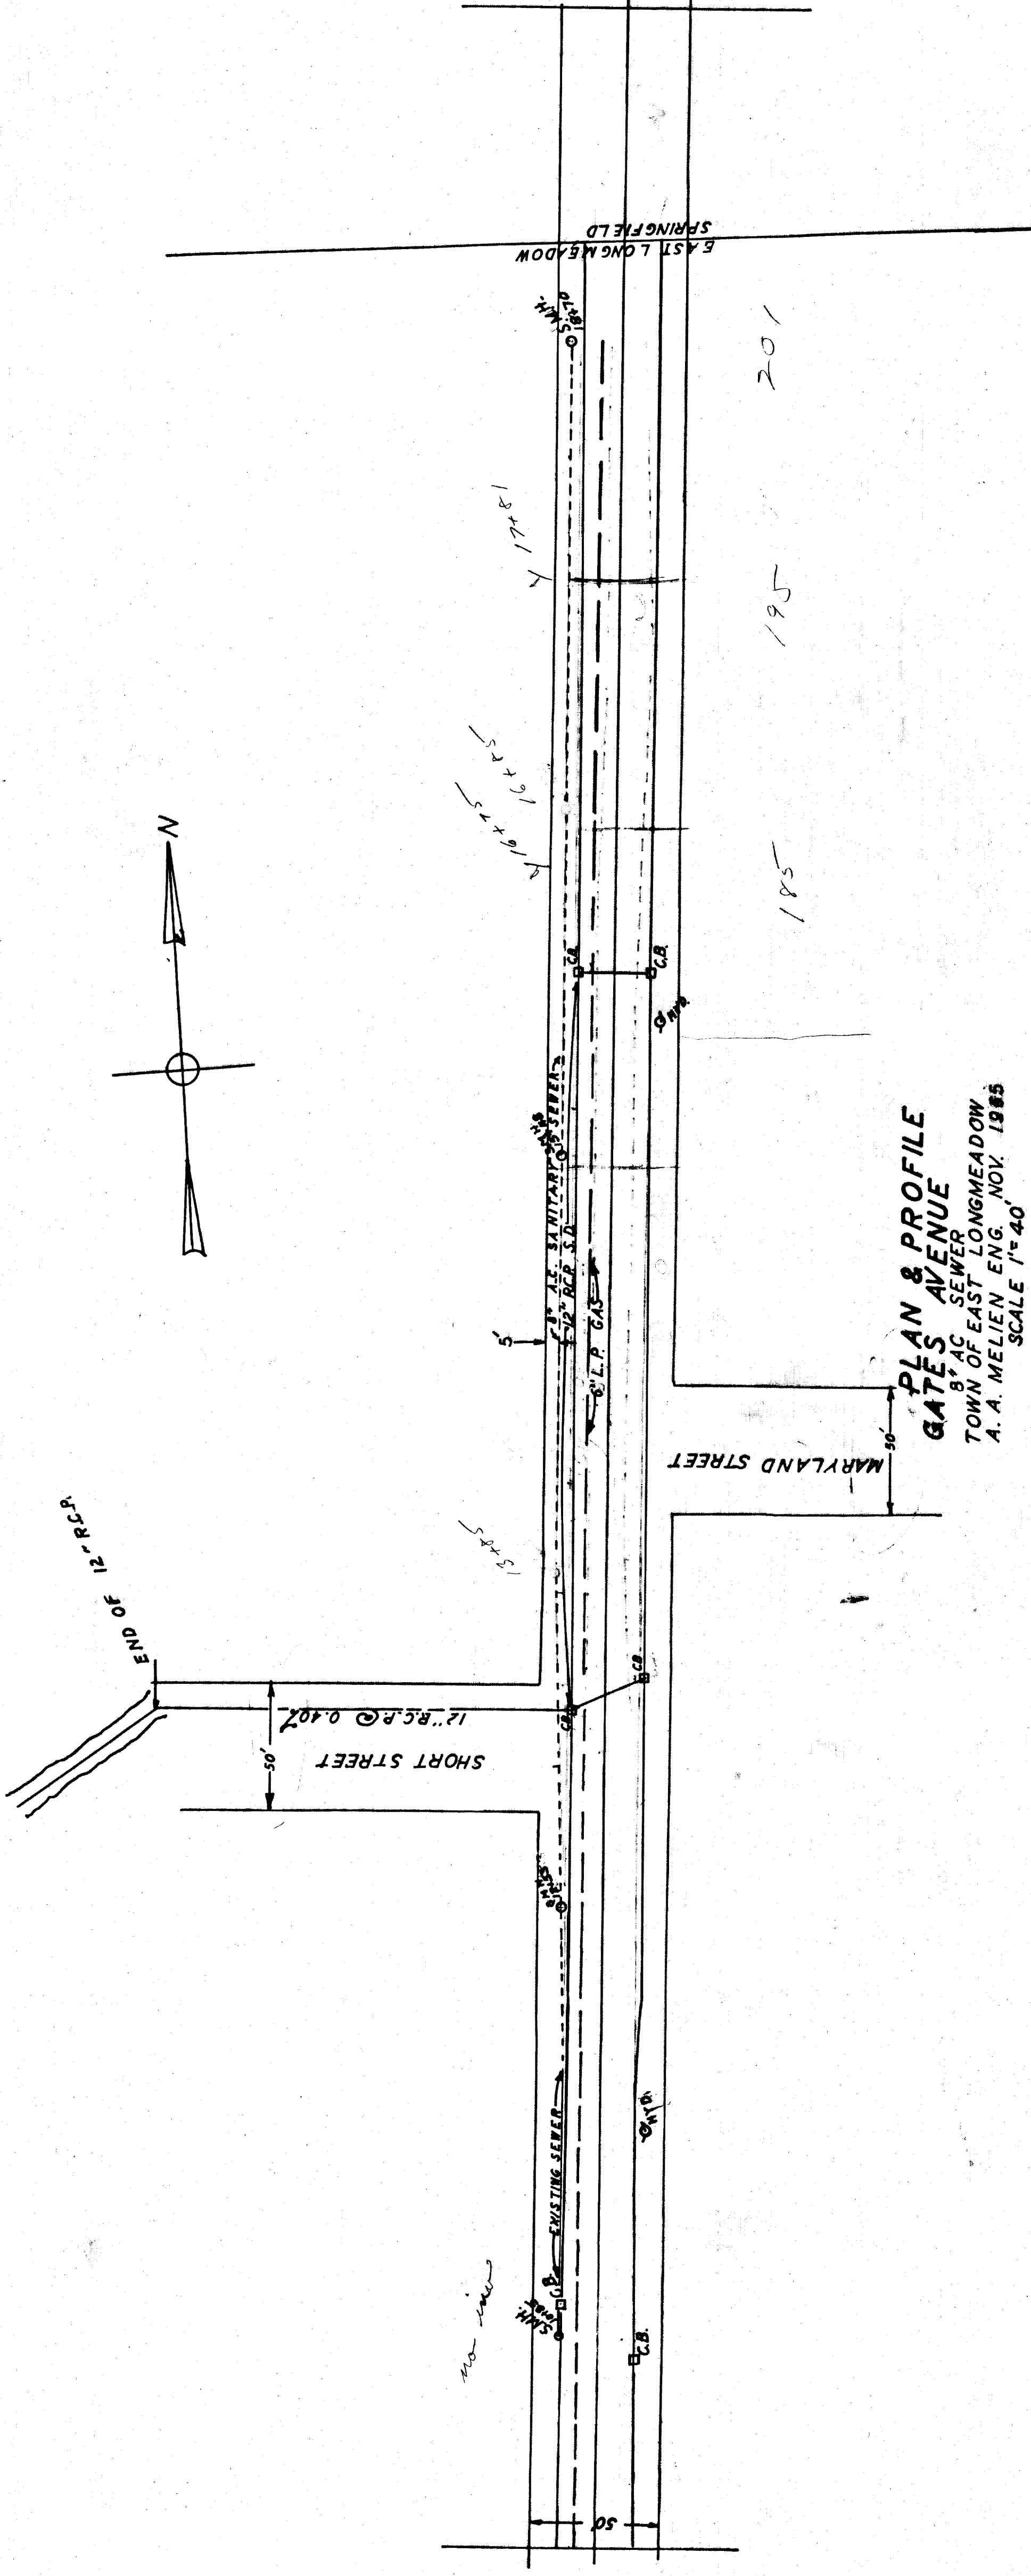

PLAN & PROFILE
 GATES AVENUE
 8" AC SEWER
 TOWN OF EAST LONGMEADOW
 A. A. MELLEN ENG. NOV. 1985
 SCALE 1"=40'

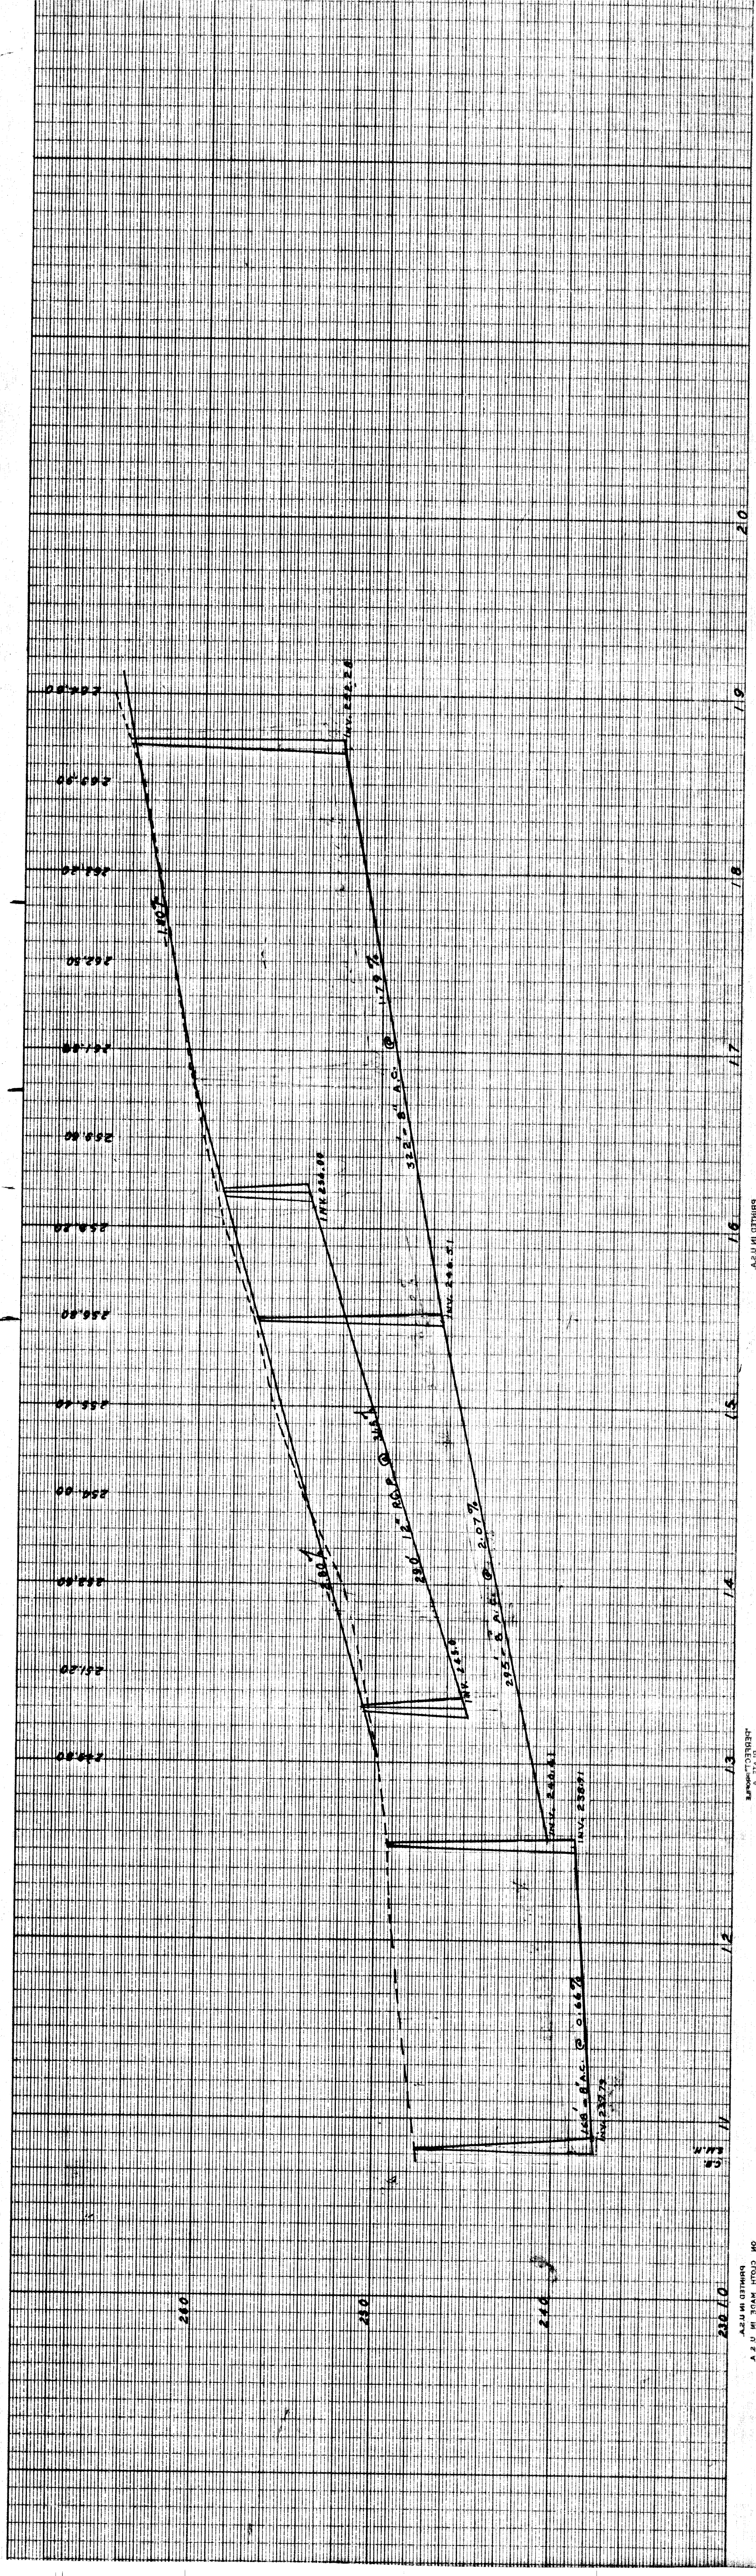

ENGINEER: ENGINEER DESIGN CO. 1000 WEST 10TH AVENUE, SUITE 100, DENVER, CO 80202
 DATE: NOV. 1985
 SHEET: 1 OF 1
 PROJECT: GATES AVENUE SEWER
 TOWN OF EAST LONGMEADOW
 A. A. MELLEN ENG. NOV. 1985
 SCALE 1"=40'