
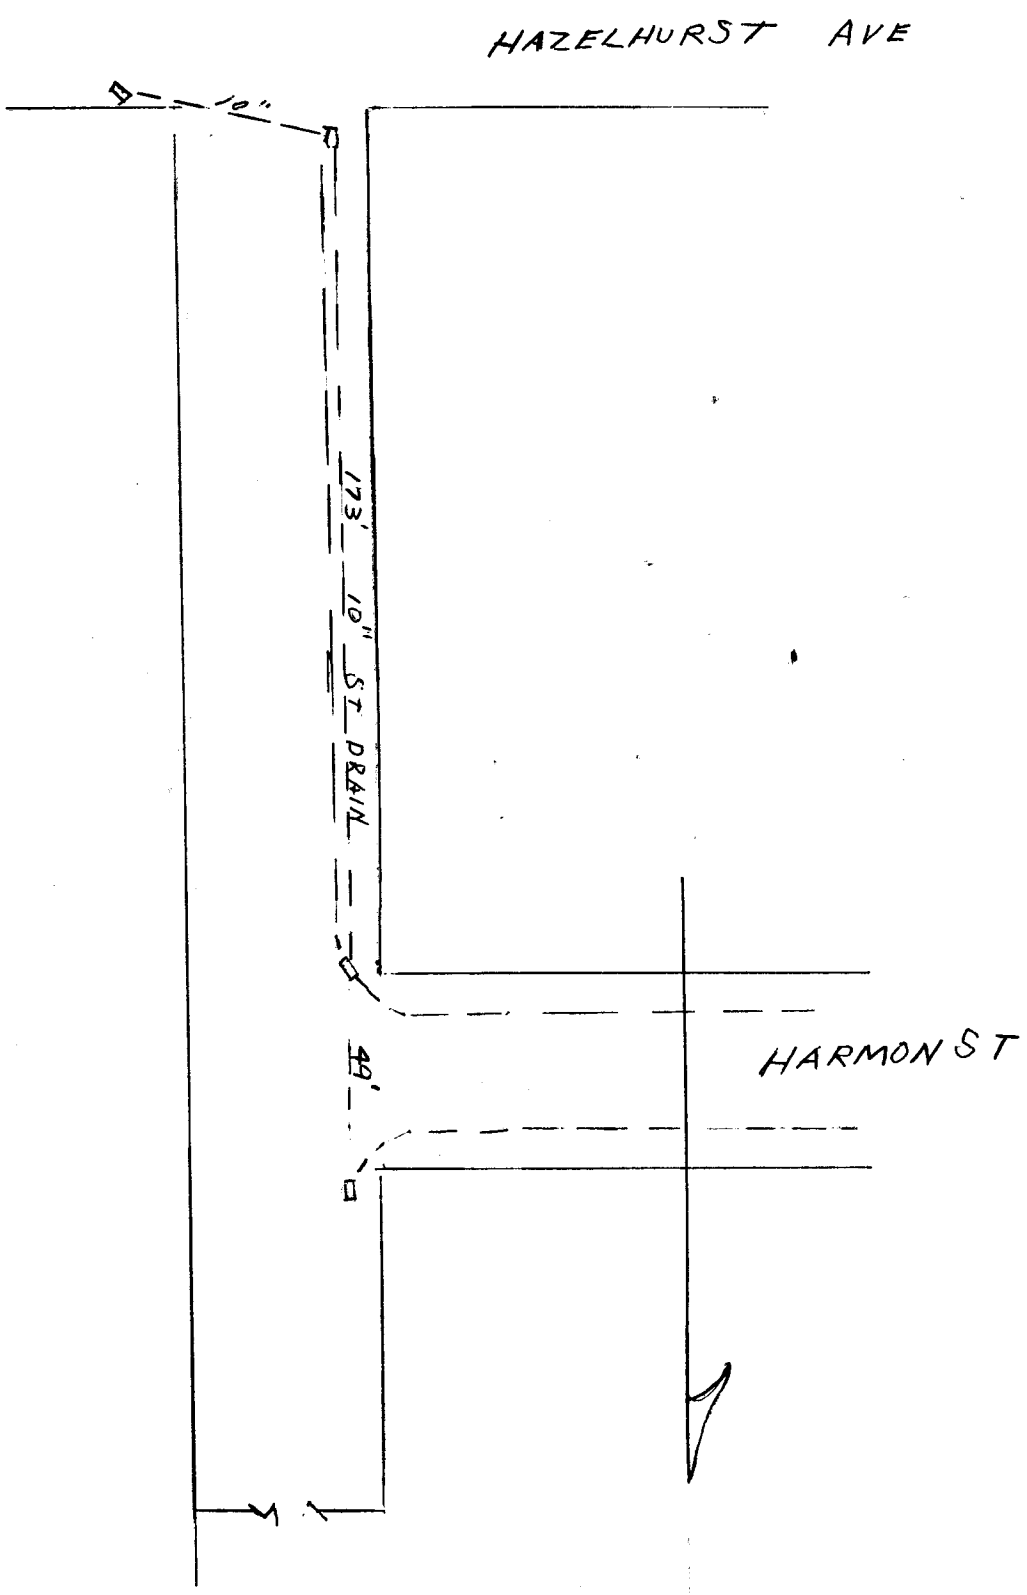


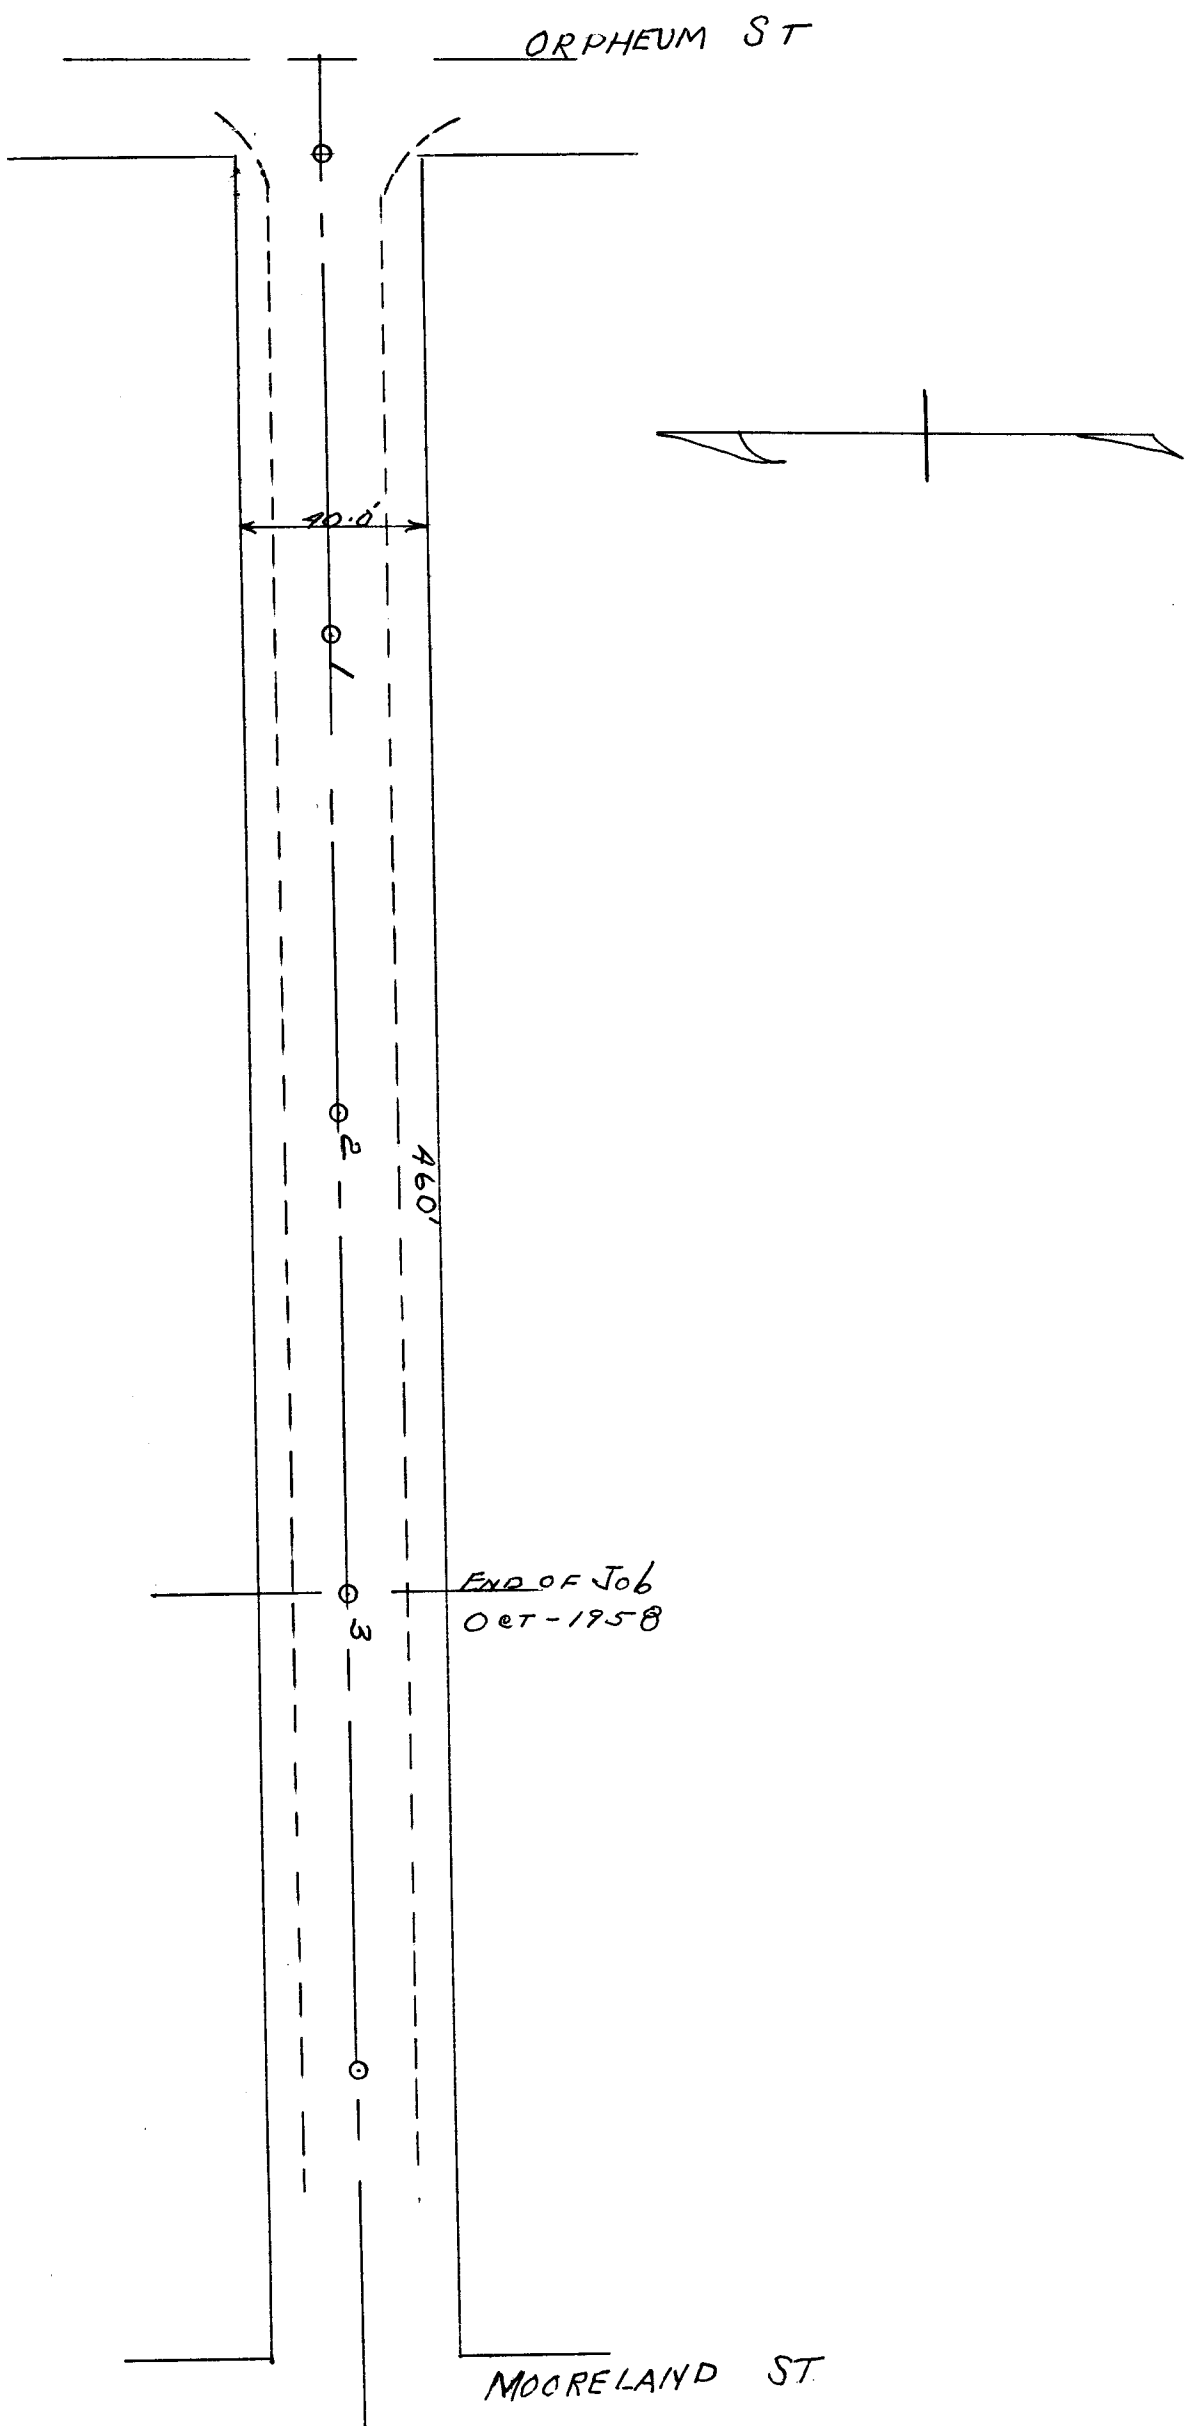

HARMON AVE

ORPHEUM ST

PLAN AND PROFILE
HARMON AVE
DEPT OF PUBLIC WORKS
TOWN OF EAST LONGMEADOW
SCALE - 1"=40 HORIZ. 1"=4 VERT.

STORM SEWER
ORPHEUM STREET
DEPT OF PUBLIC WORKS
TOWN OF EAST LONGMEADOW
SCALE - 1"=40 HORIZ. 1"=4 VERT.

ORPHEUM AVE
208.57

50.78

0.816 GR.

204.09

EXISTING CB
90.00

100

10' - 173.0'

97.94

49.0'

98.10

ASSUMED ELEV. RIM EXISTING CB = 100.0
ELEV. CENTER AT GRATE