




SCALE: 1"=20' HORIZ.
1"=2' VERT.

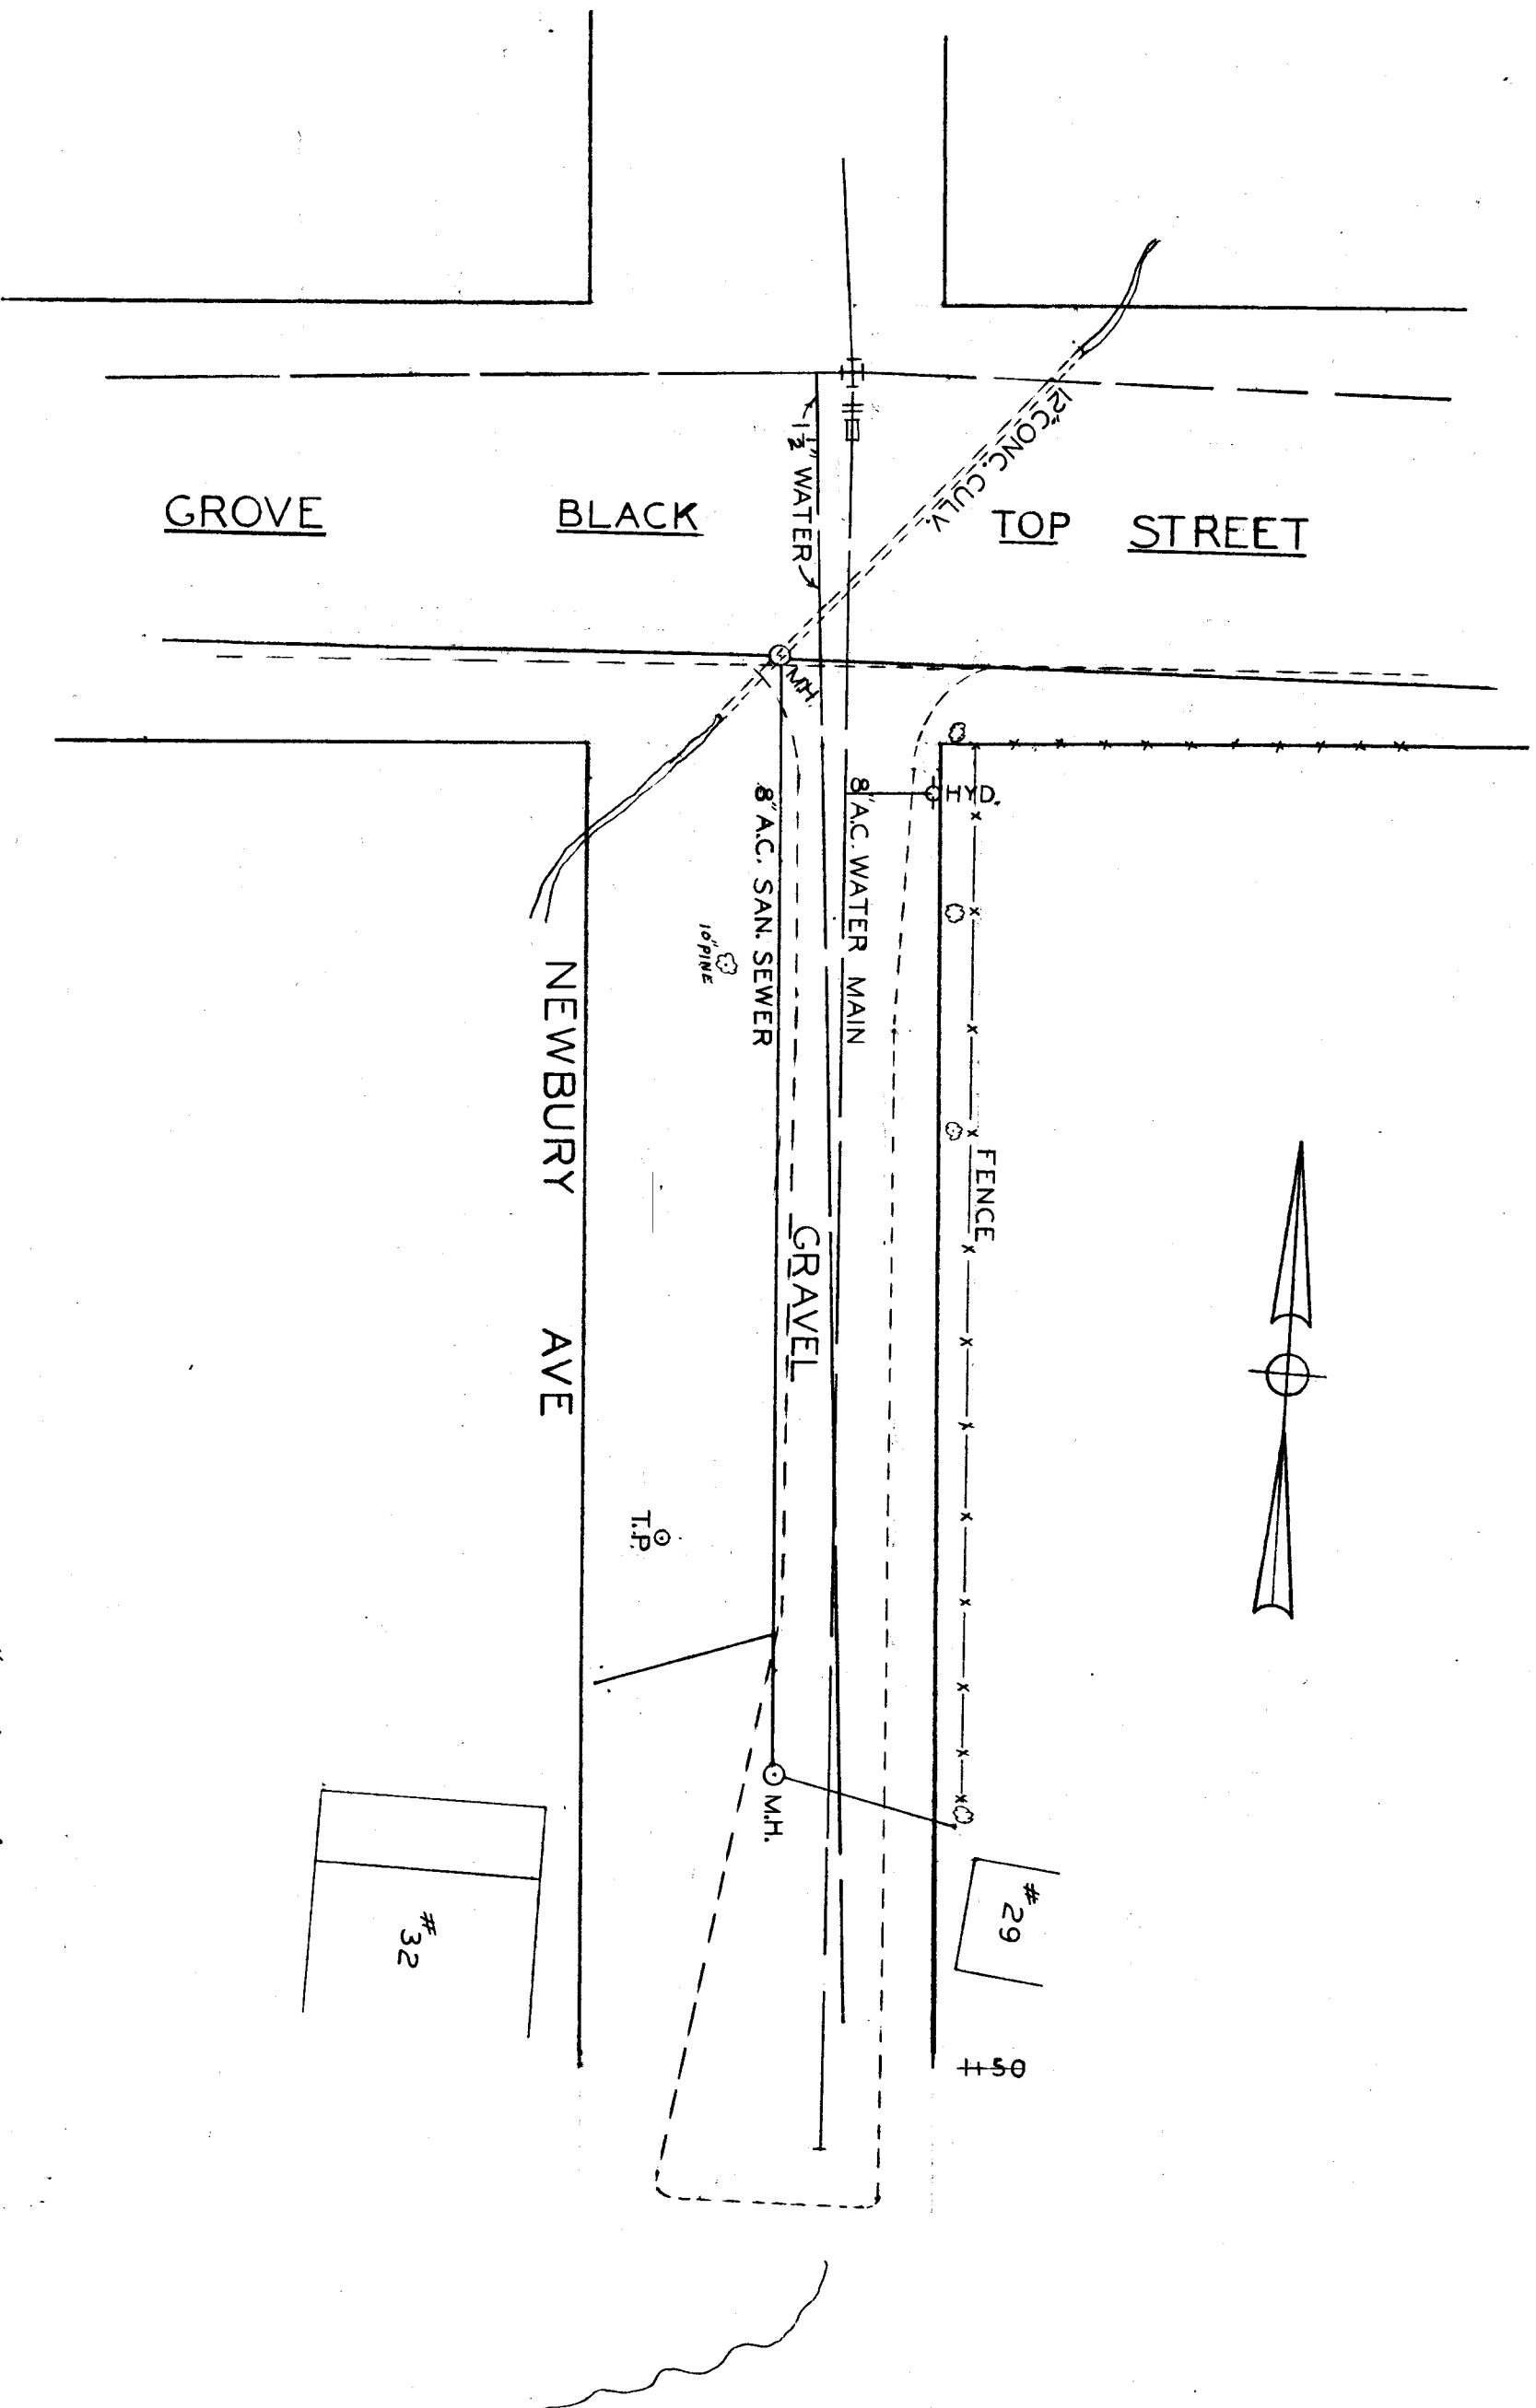