


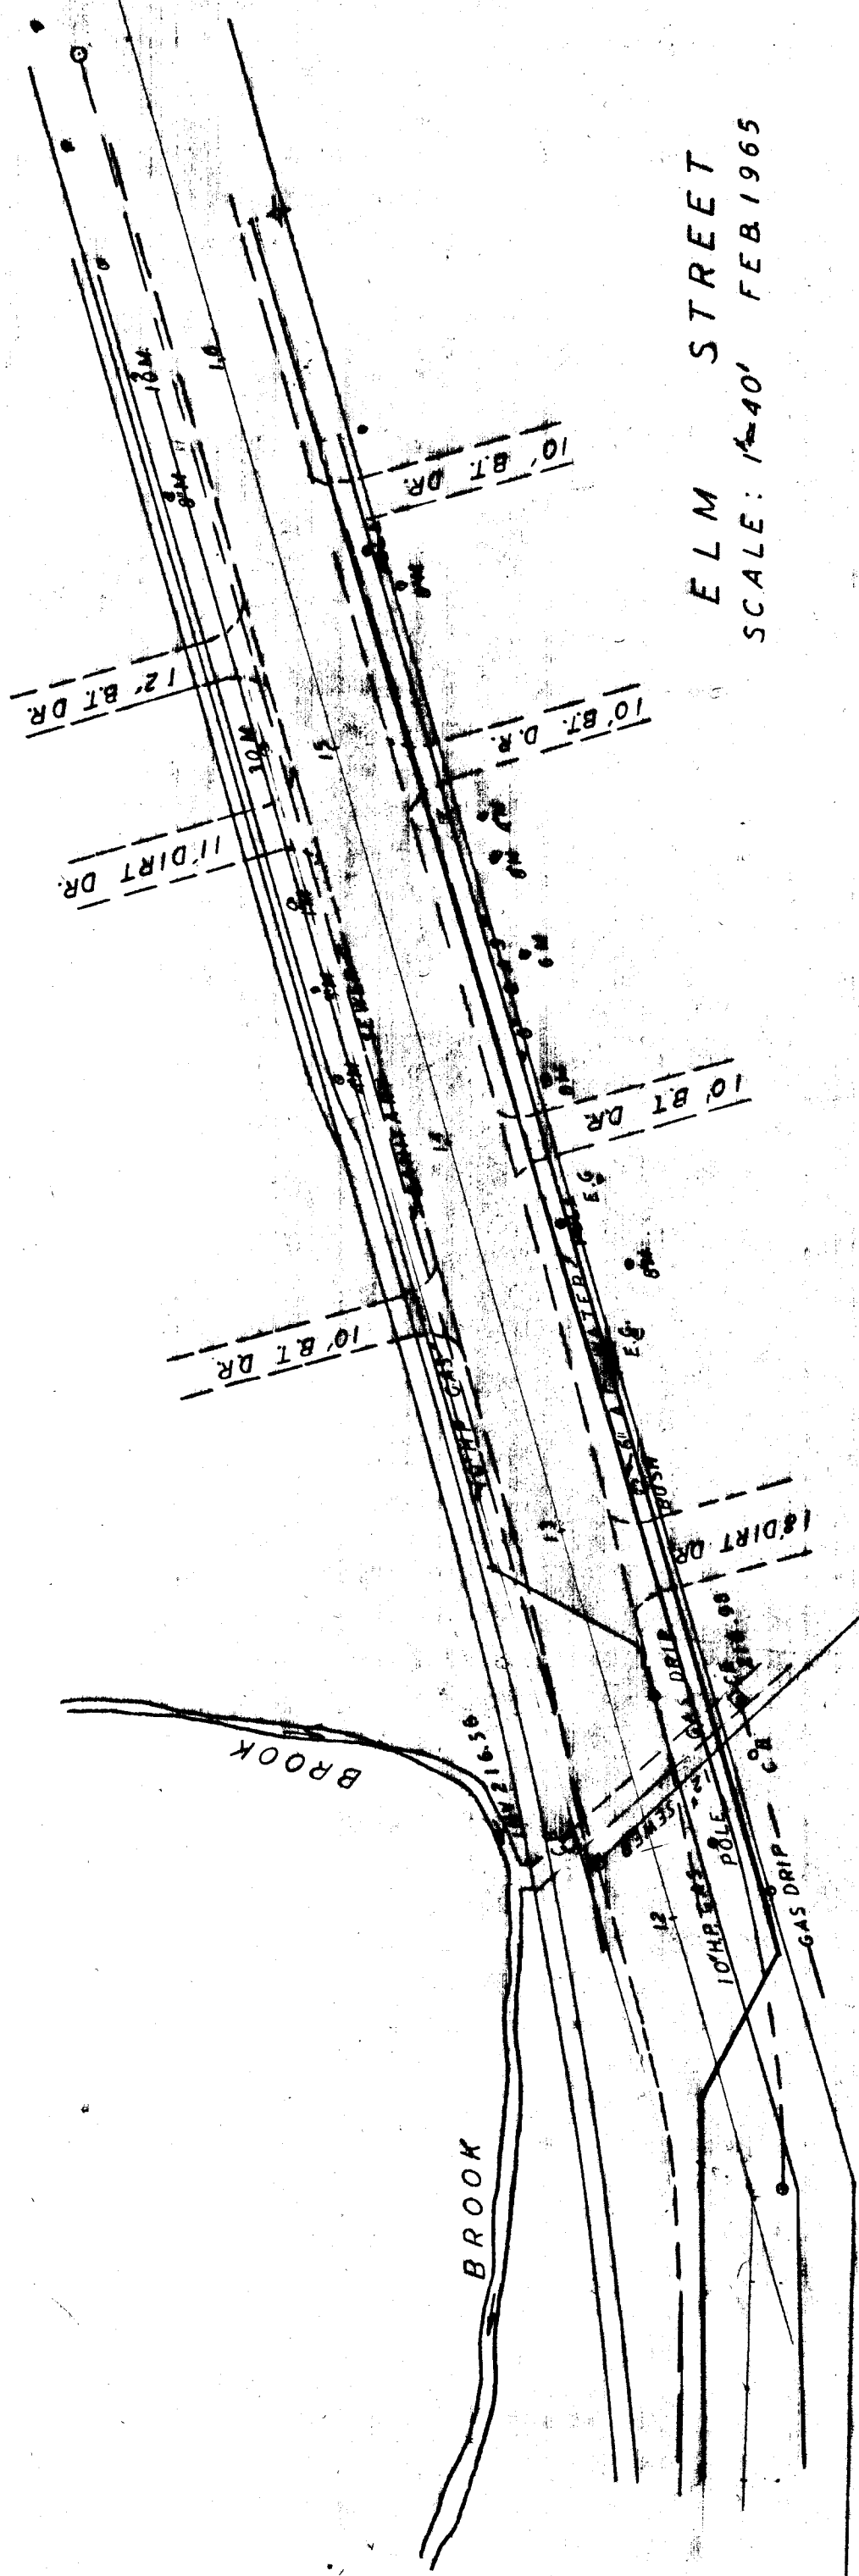

ELM STREET
SCALE: 1"=40' FEB 1965

230

220

210

SHAN SEWER 10" DIA