
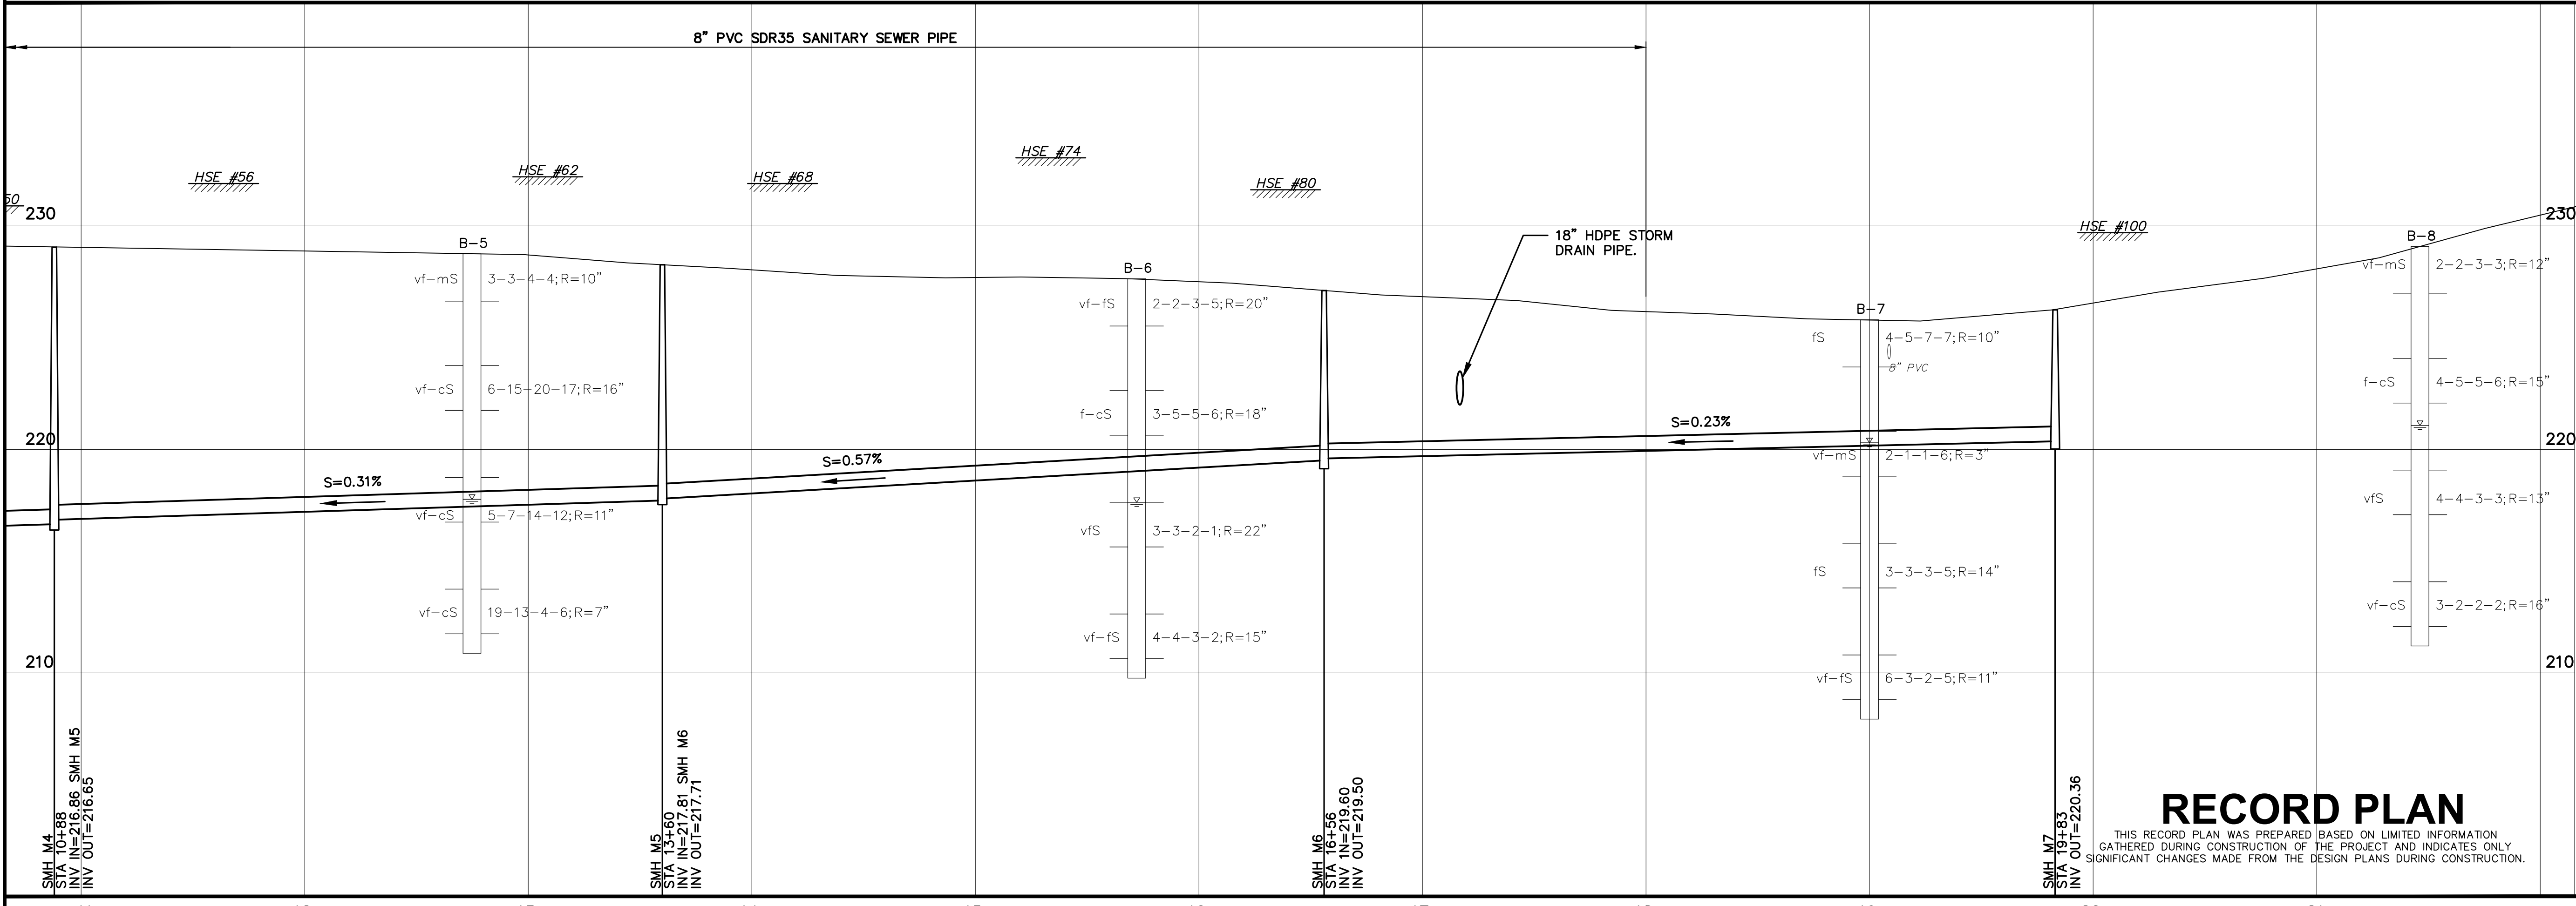


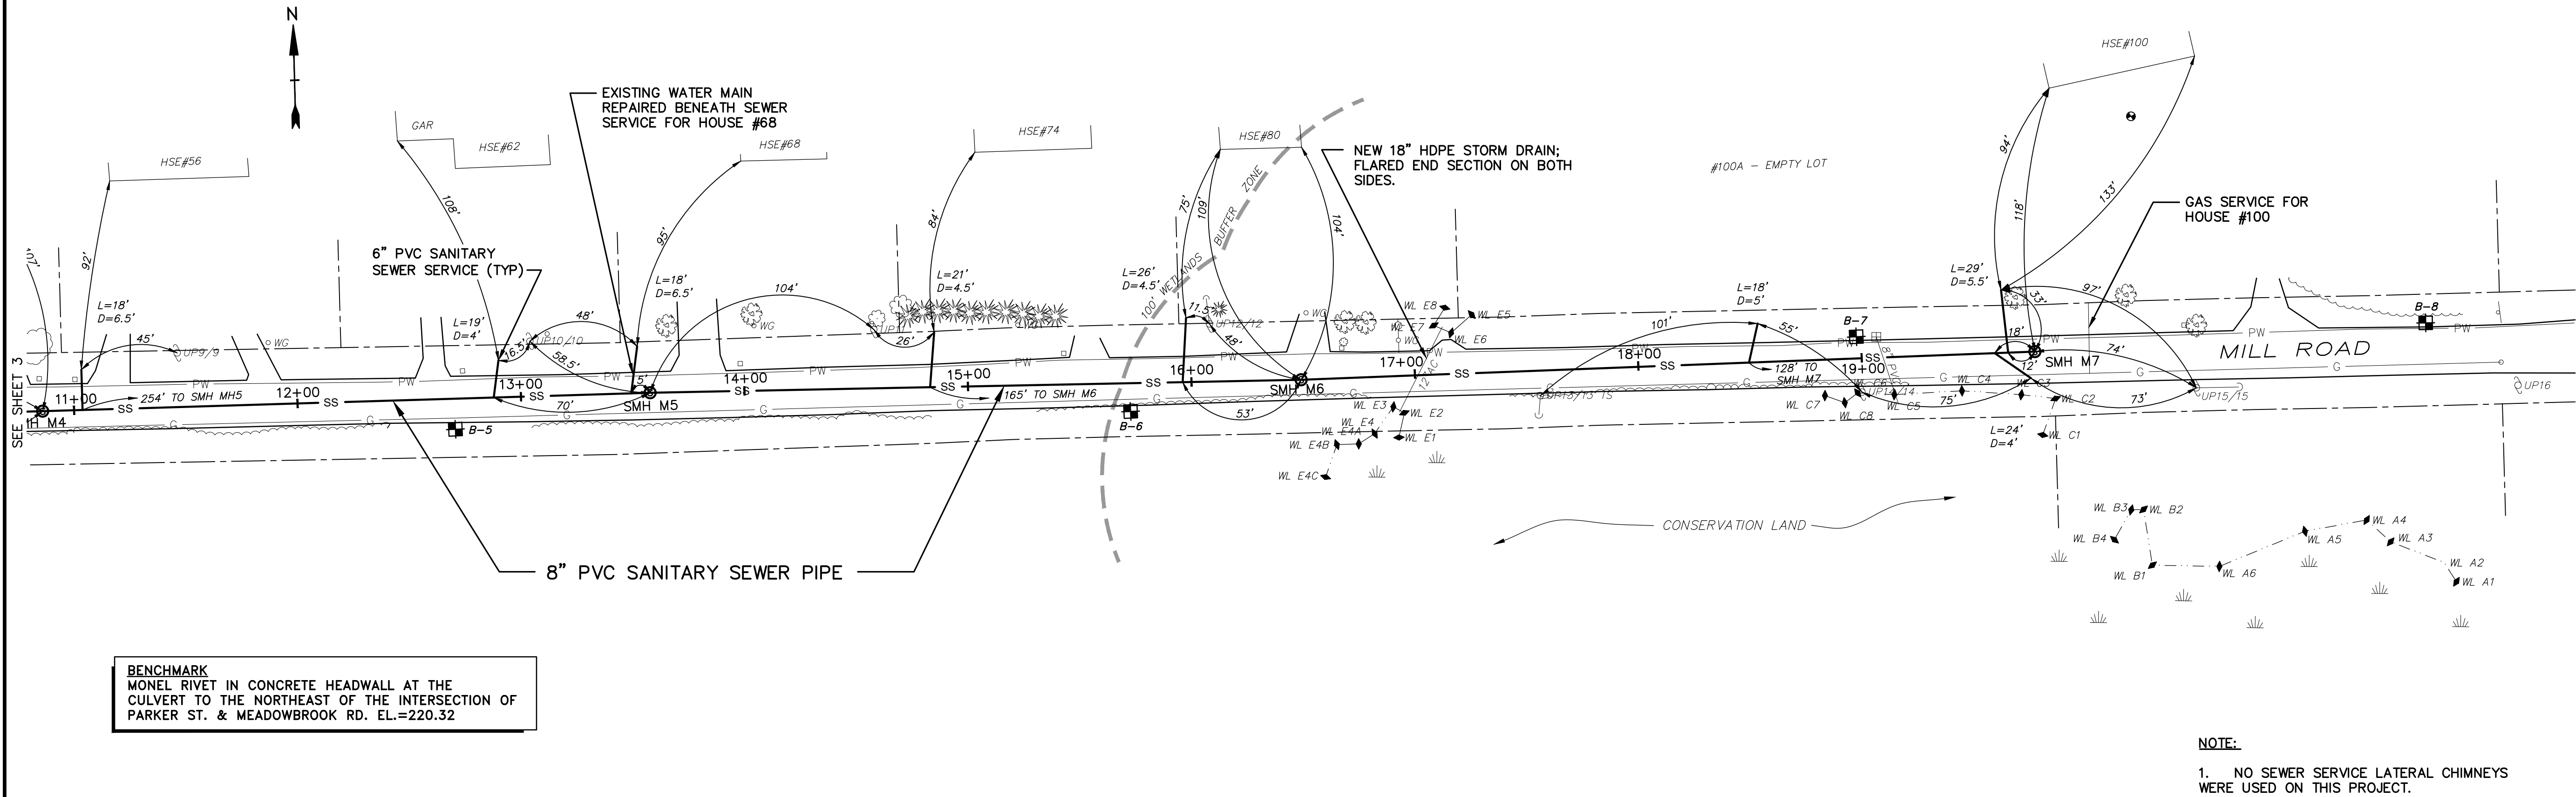

Board of Public Works

Mill Road Sanitary Sewer Project

East Longmeadow, Massachusetts

1	12/15/05	RECORD PLAN
Mark	Date	Description
PROJECT NO: E0451117		
FILE:E0451117 Mill Road/PLAN.dwg/SHEET4		
DRAWN BY: ARG		
CHECKED: DRP		
APPROVED BY: RP/MP		
MILL ROAD		
STA 11+00 TO STA 18+00		
SCALE: 1"=40 H; 1"=4" V		