


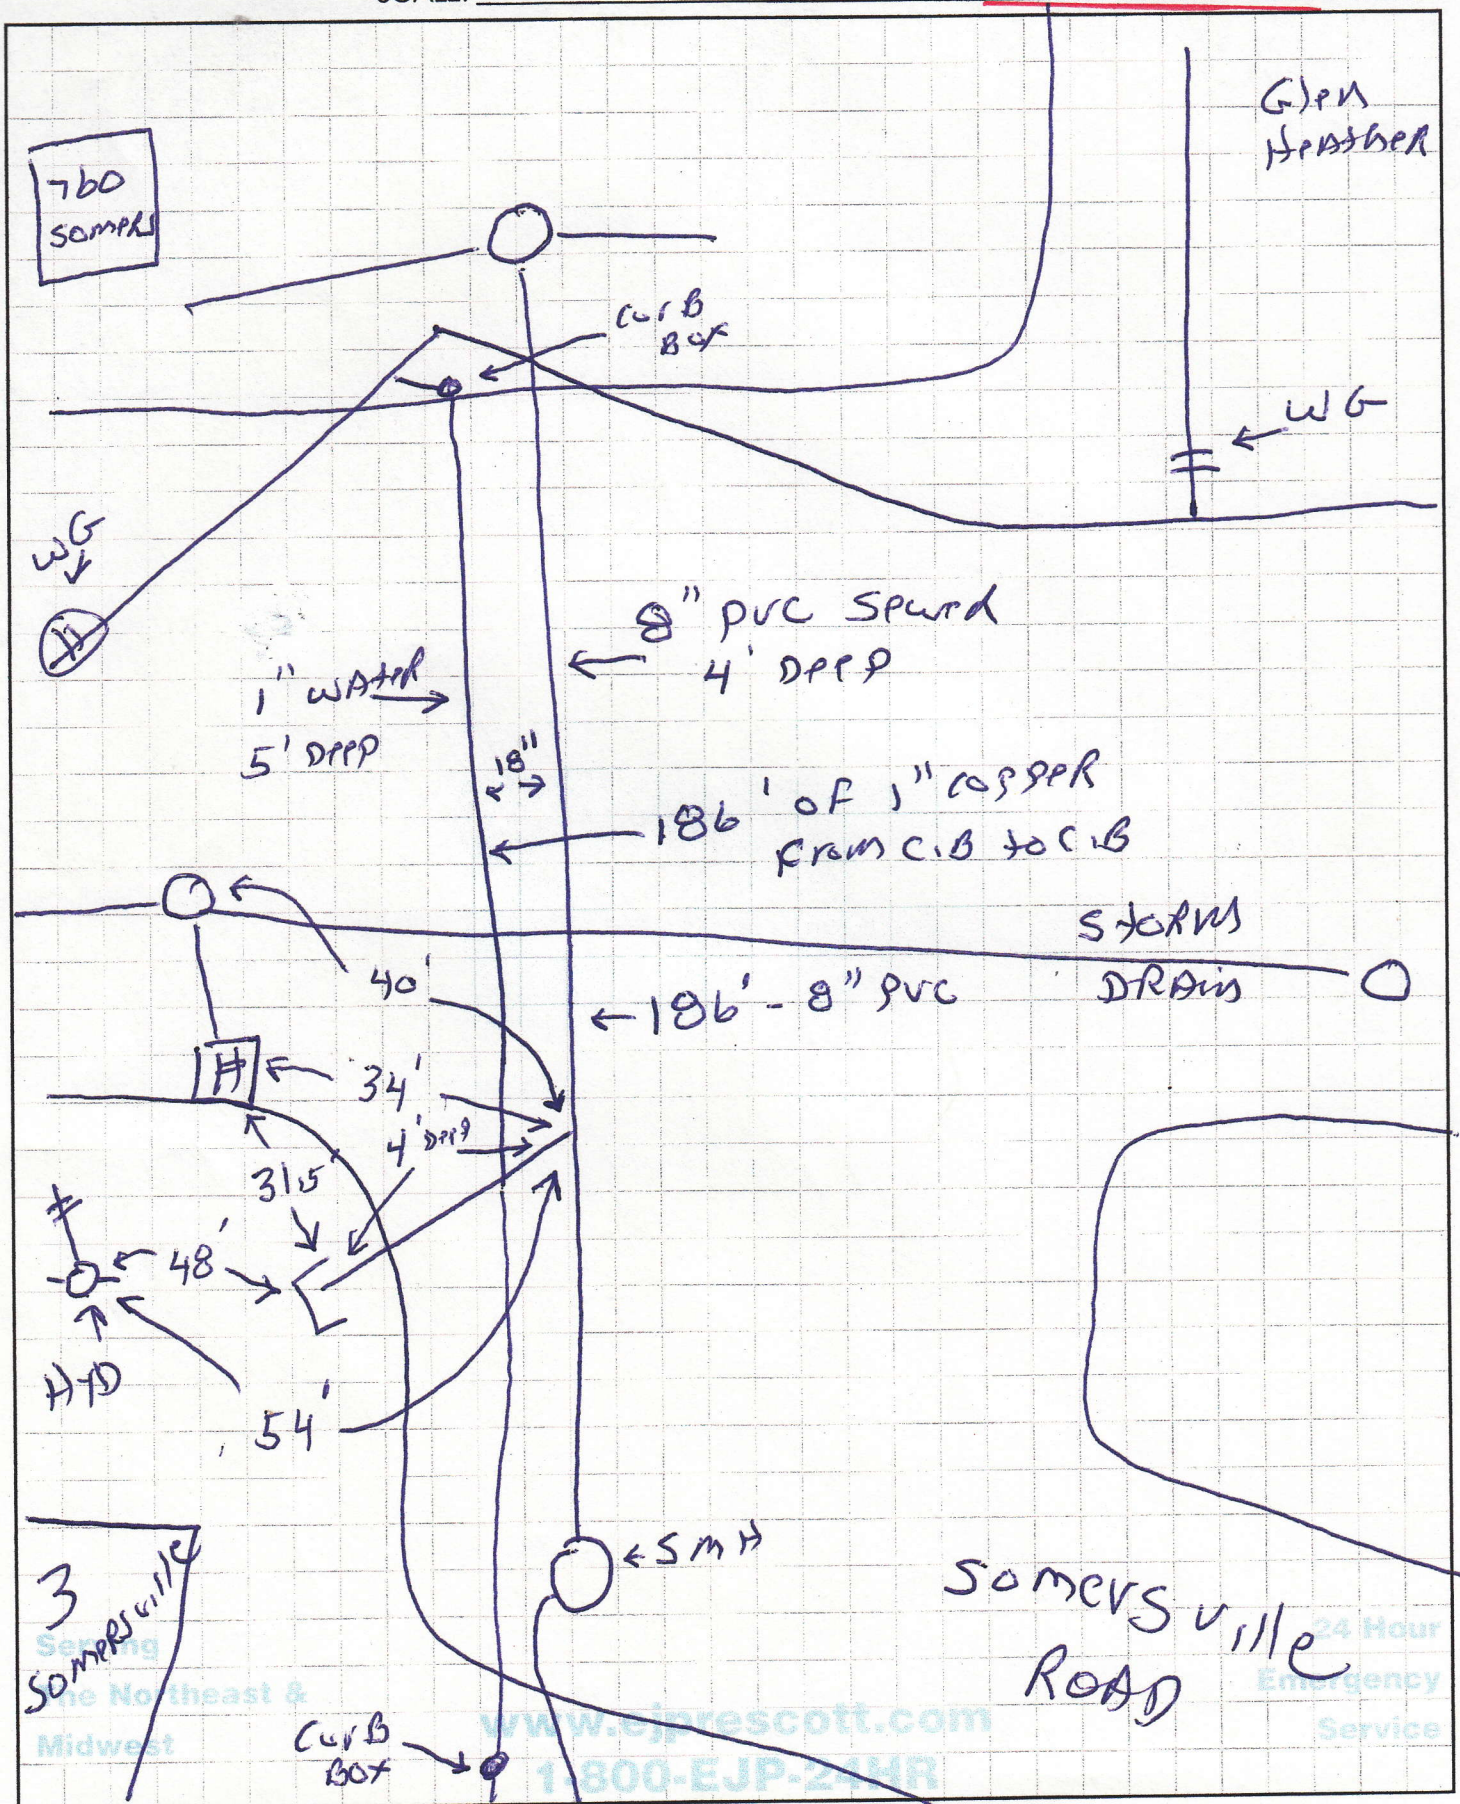

24 Hour
 Emergency
 Service

www.ejprescott.com
 1-800-EJP-24HR