

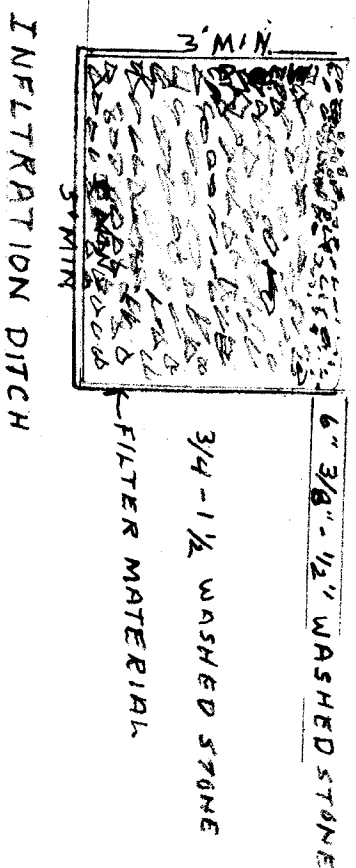


ROADWAY TO BE 24'  
WIDE - 12" OF GRAVEL  
BASE - 2" OF BIT. CONC.  
BINDER MATERIAL


ONE TEN FOOT LENGTH  
OF D.I. PIPE & GATE VALVE  
EXISTING PER E.L.M. D.P.W.

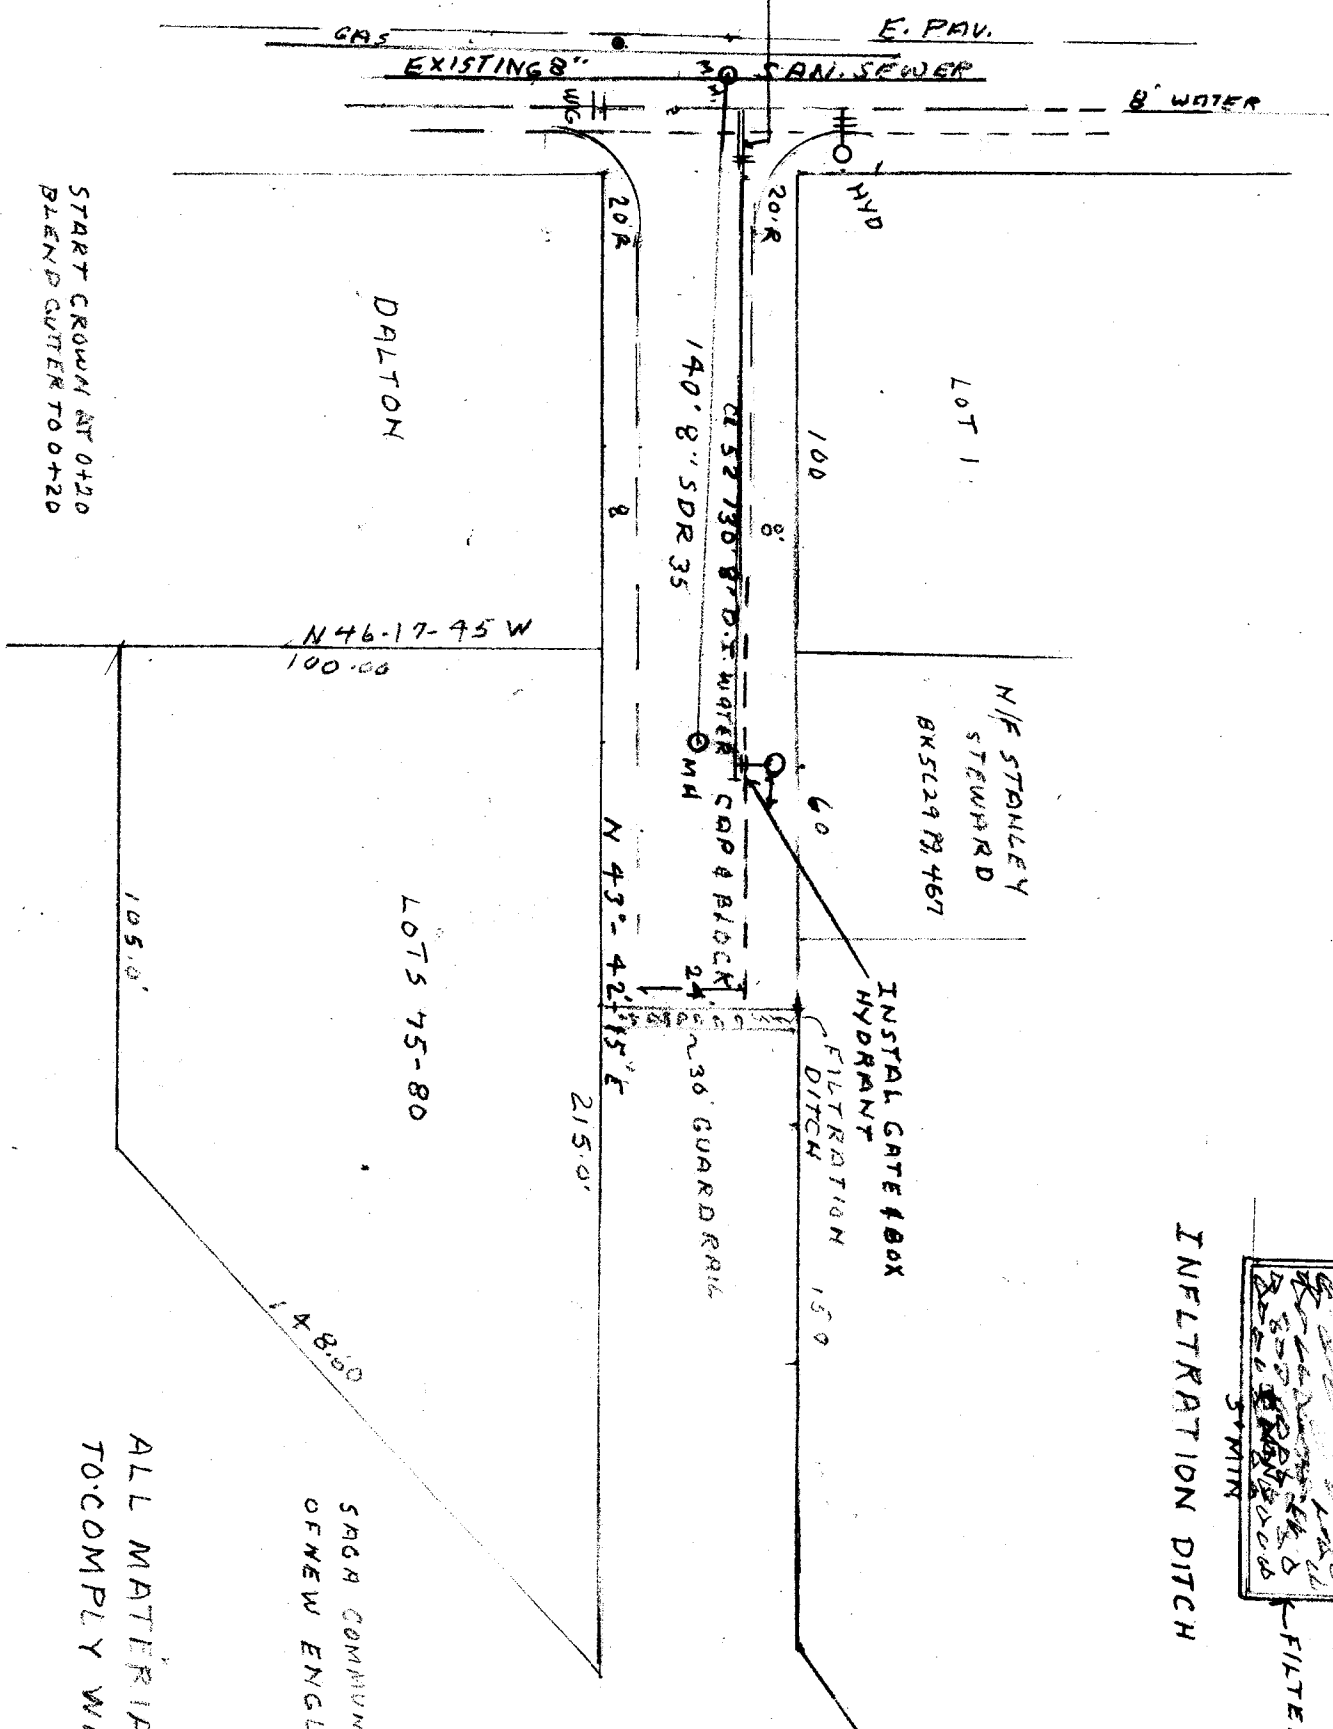

ALL MATERIALS & CONSTRUCTION METHODS  
TO COMPLY WITH E.L.M. D.P.W. STANDARDS

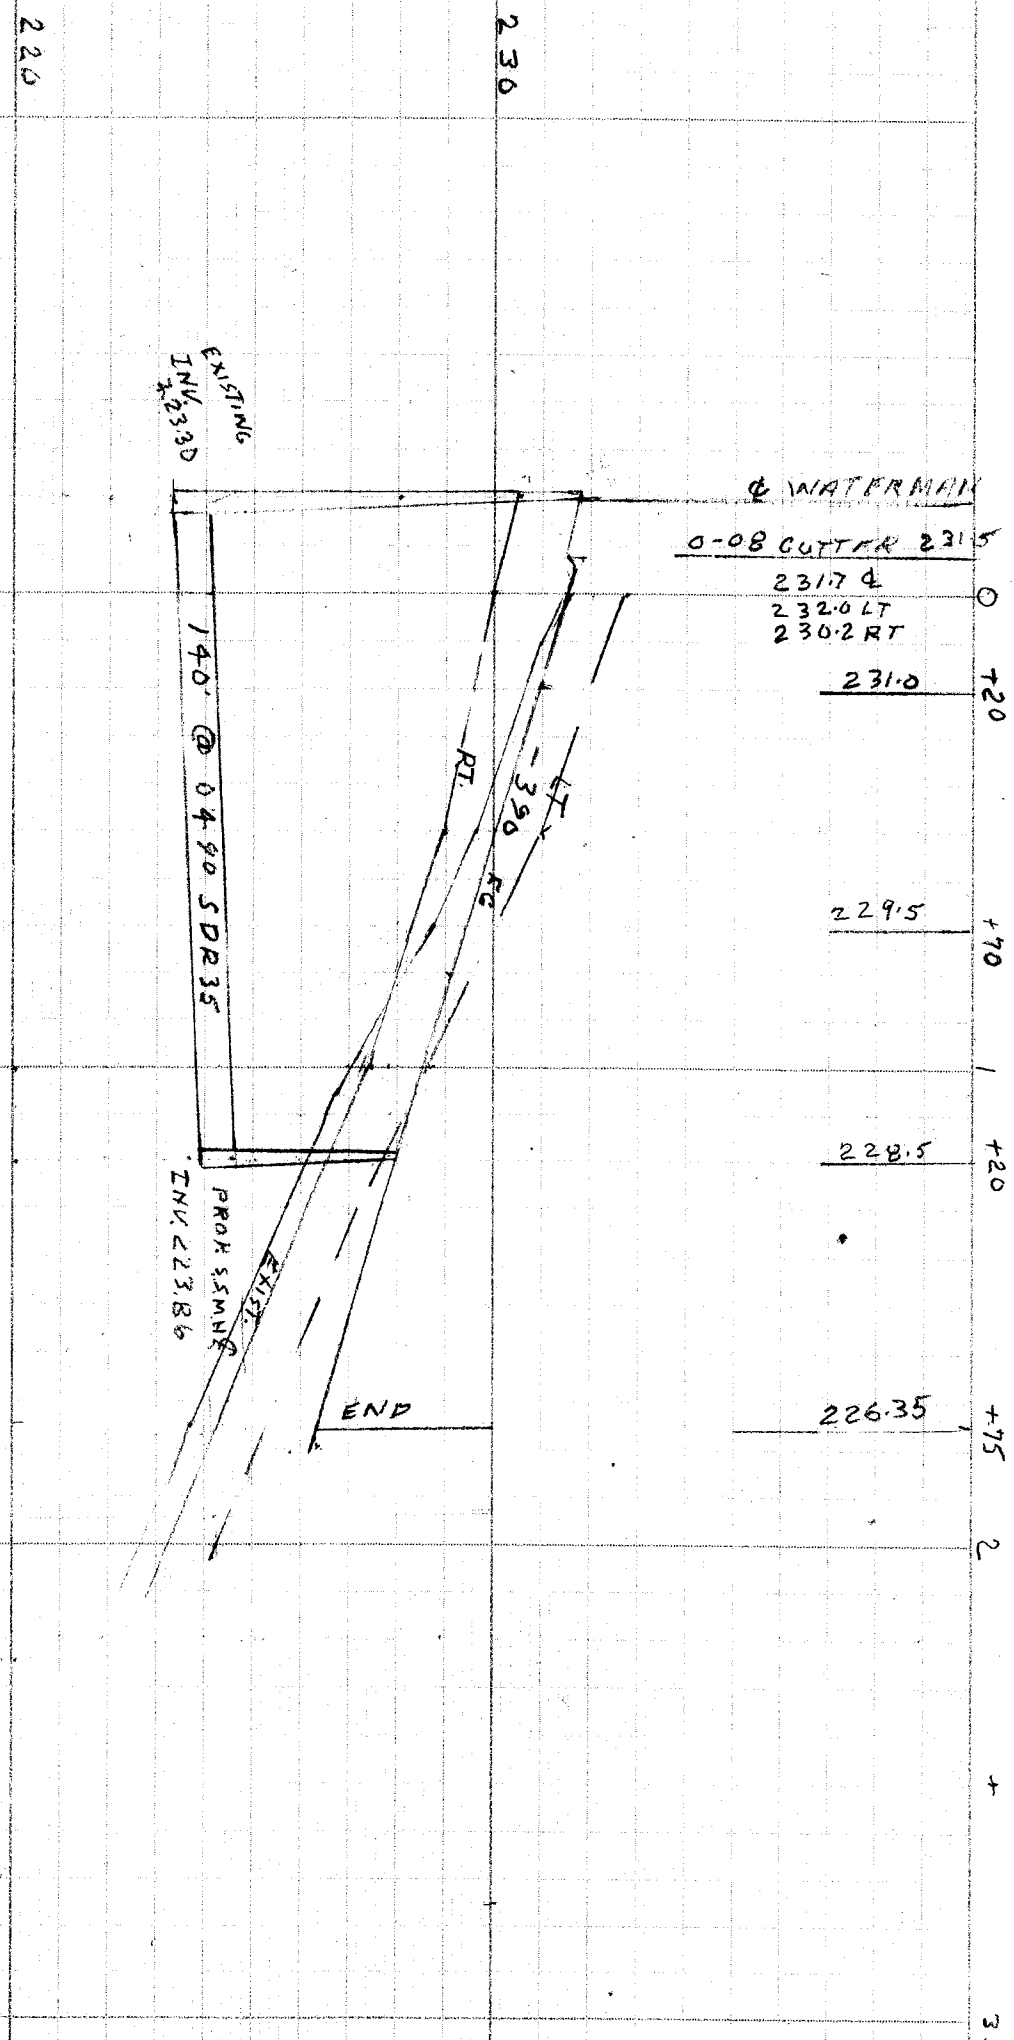

REVISED SHOWING HYD. 9-16-02

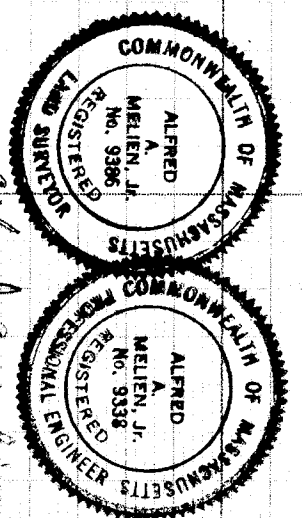

PLAN & PROFILE  
DALE STREET  
EAST LONGMEADOW MA.  
PREPARED FOR  
G.E.M. HOLDING  
SCALE HORIZ. 1" = 40'  
VERT. 1" = 4'  
6-26-02  
A.A. MELIEN, R.L.S.  
P.E.