
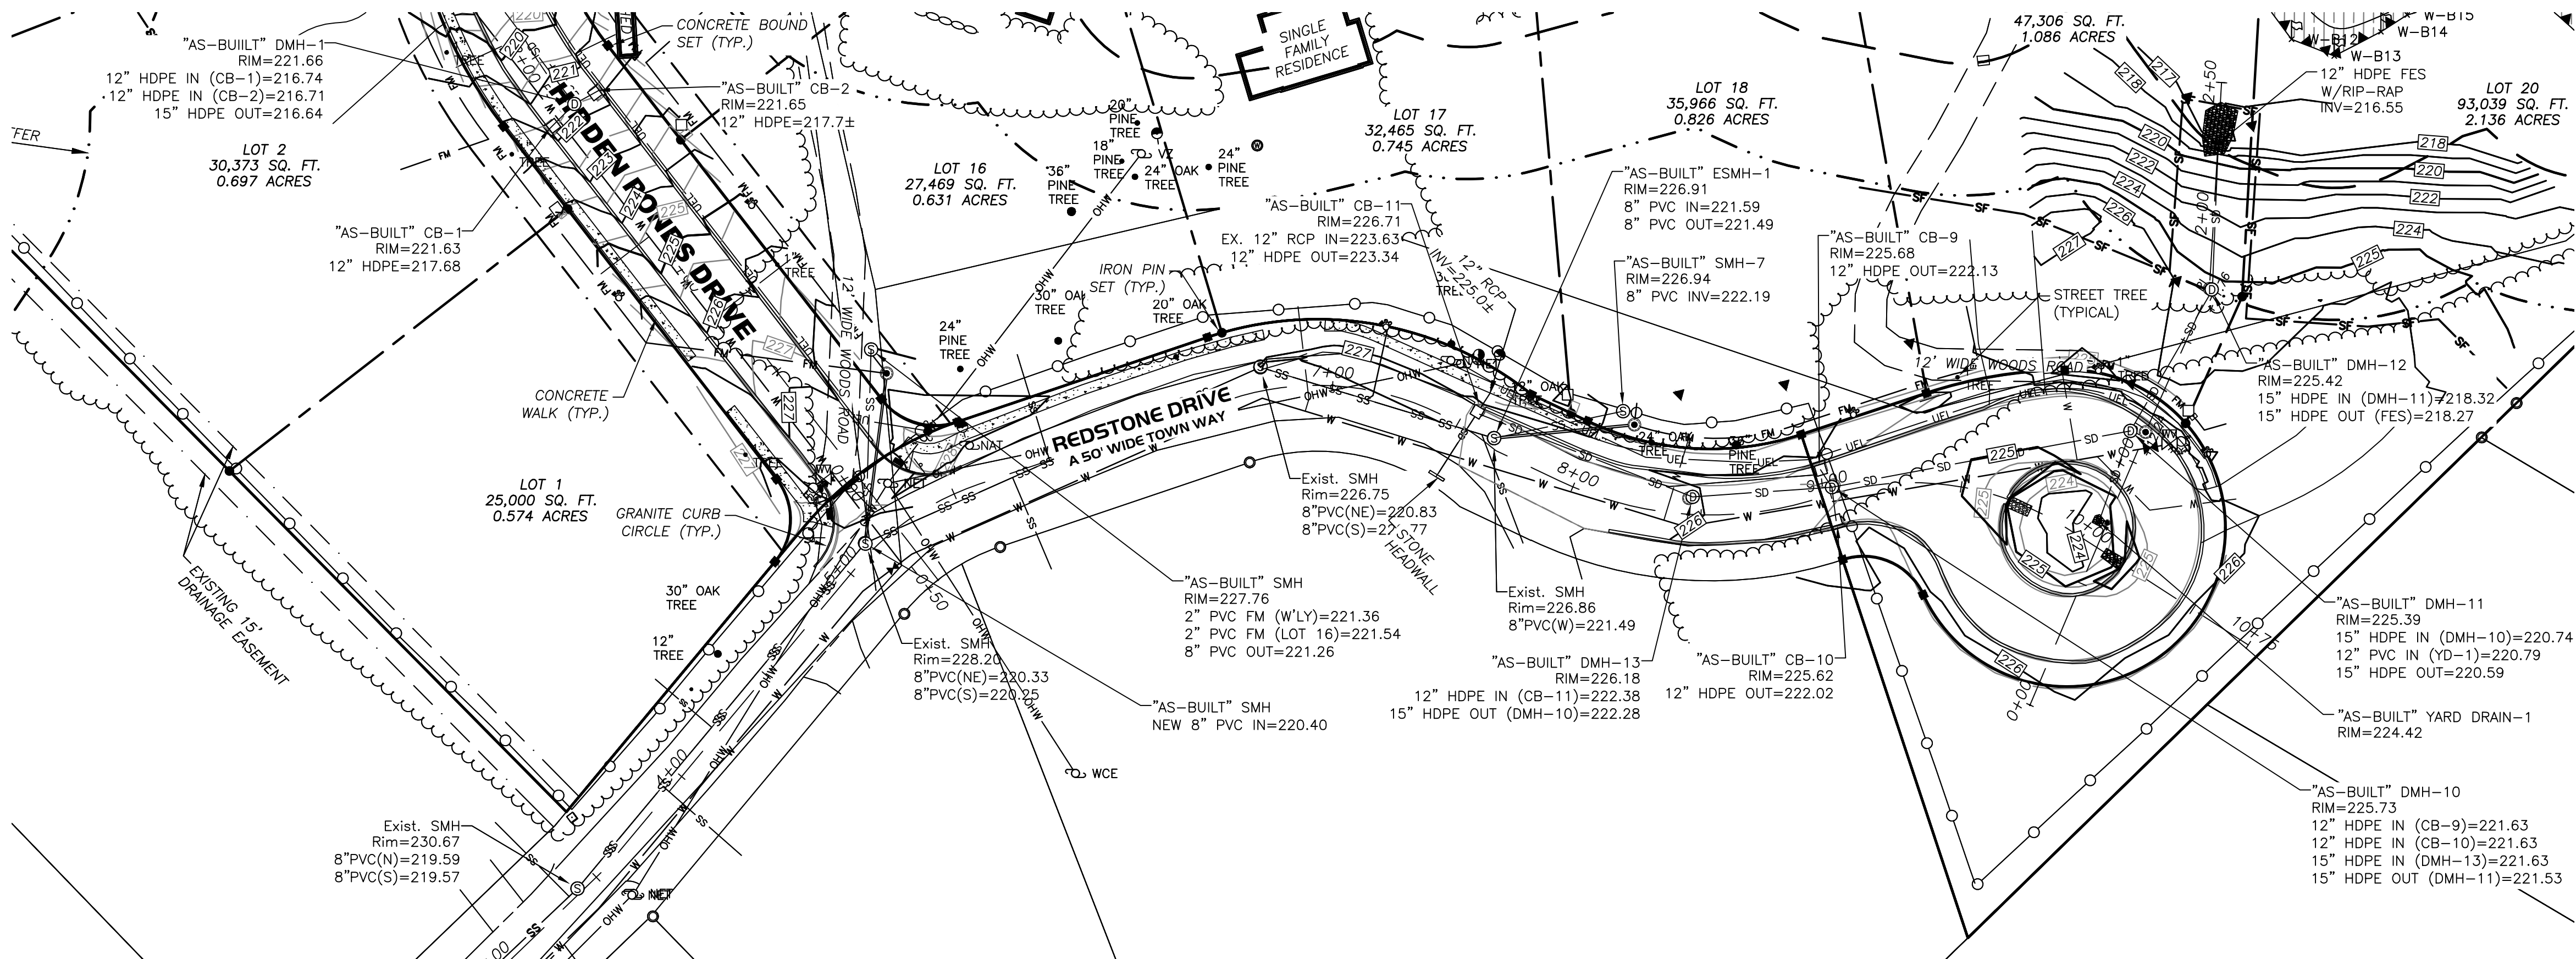
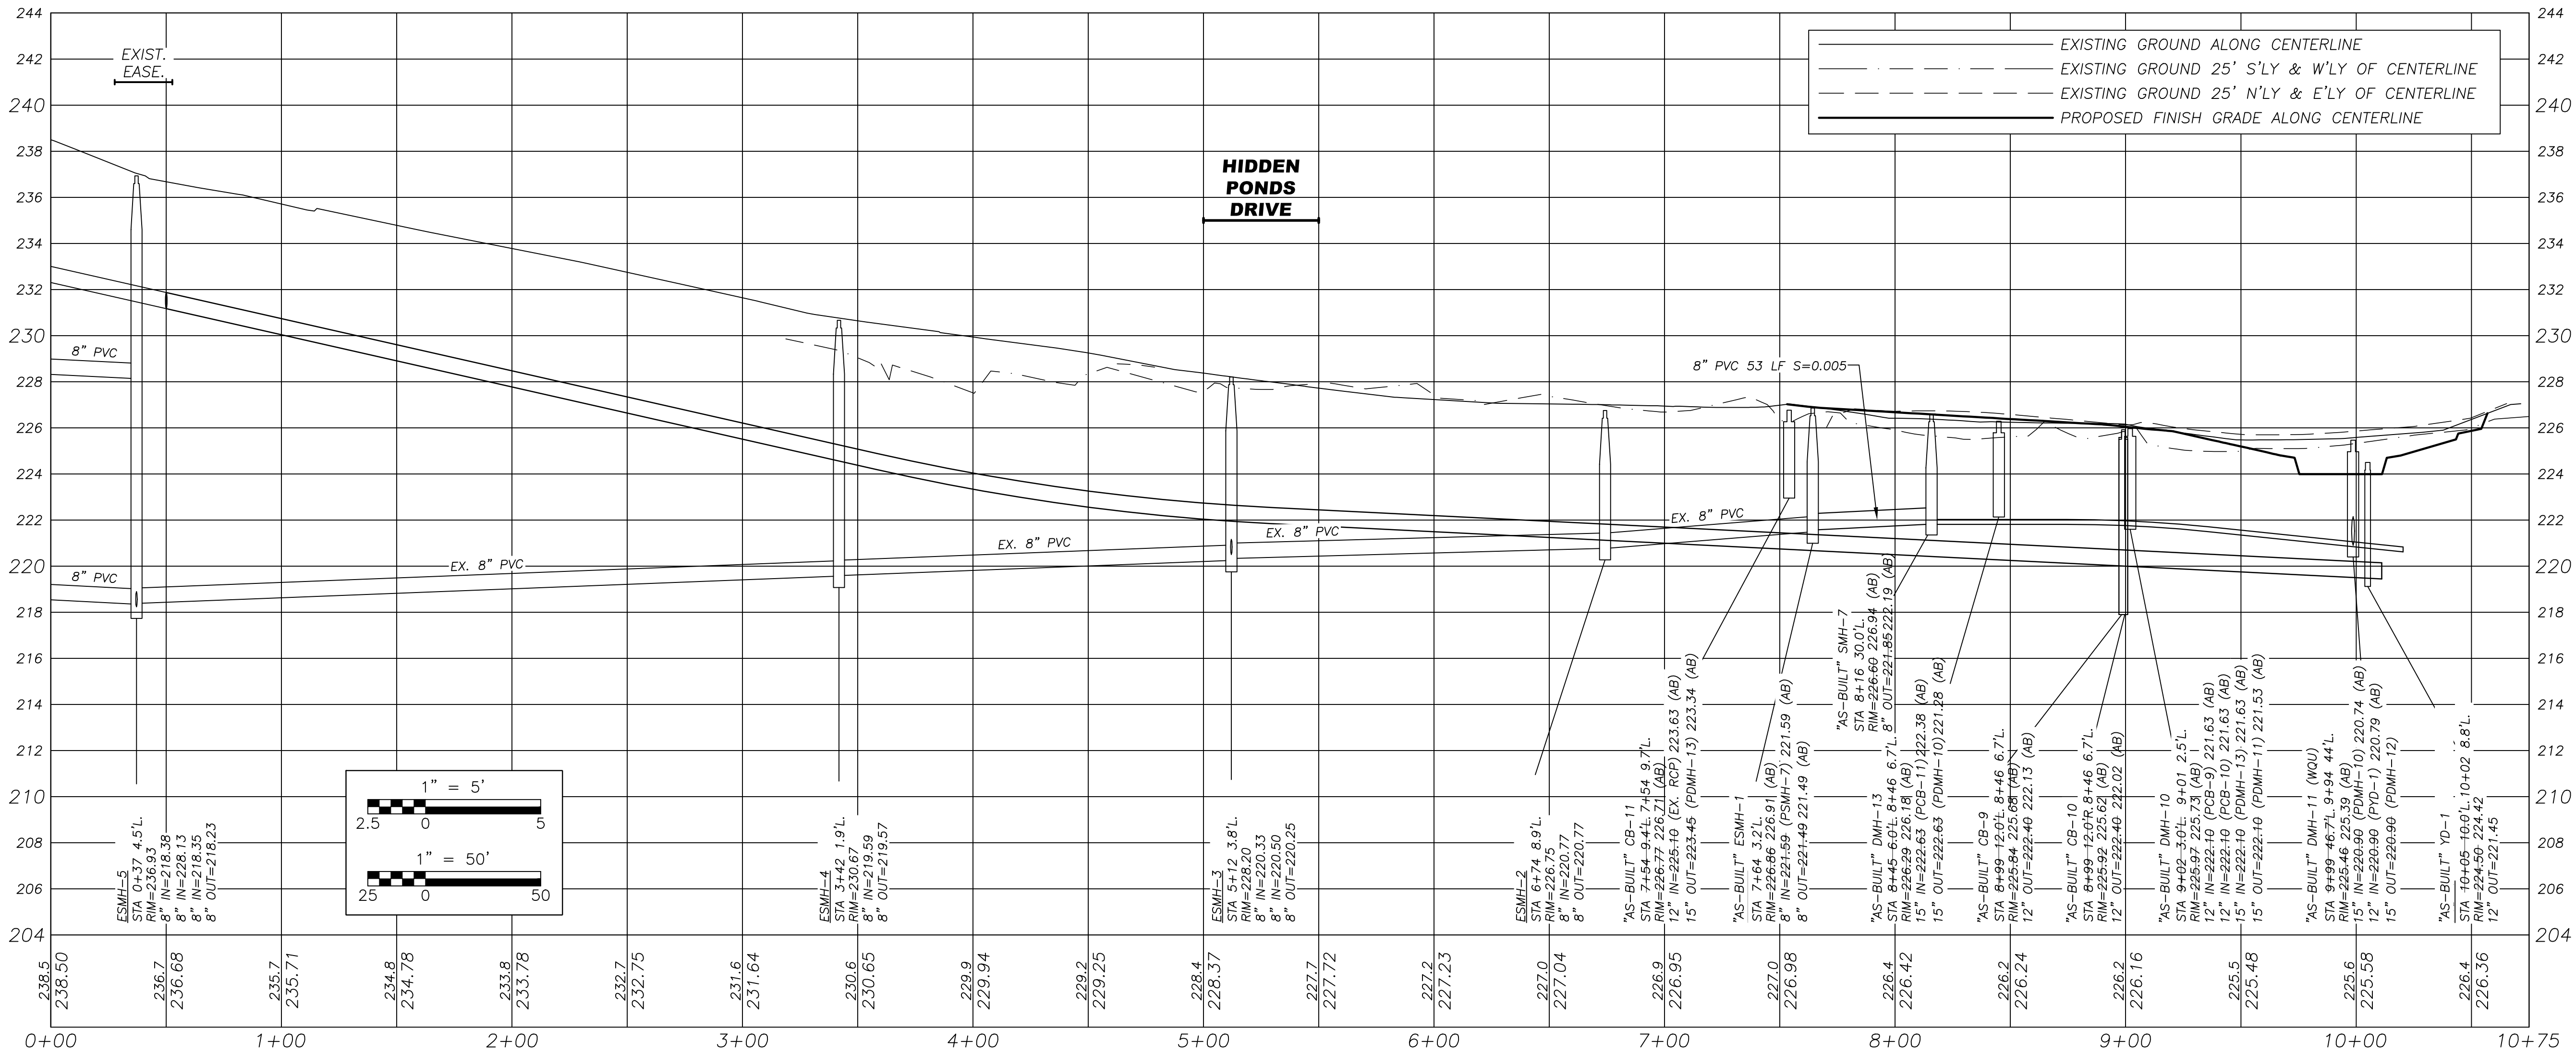


S:\Projects\2017\171109 - Joyce - Red Stone Dr, East Longmeadow\Civil 3D\171109 - Subdivision As-Built.dwg

NOTES

1. THE SUBDIVISION DEVELOPER IS BEDROCK FINANCIAL, LLC D/B/A ROSE BUD BUILDERS.
2. FOR DEFINITIVE SUBDIVISION PLANS SEE HAMPDEN COUNTY REGISTRY OF DEEDS PLAN BOOK 385 PAGES 33-34.
3. THIS PLAN HAS BEEN PREPARED FOR SITE PLANNING PURPOSES AND SHALL NOT BE USED FOR THE CONVEYANCE OF LAND OR FOR ANY OTHER USE.
4. "AS-BUILT" SUBDIVISION INFORMATION DEPICTED HEREON IS DERIVED FROM AN ON-GROUND INSTRUMENT SURVEY BY R LEVESQUE ASSOCIATES, INC. PERFORMED BETWEEN JULY 19 AND OCTOBER 5, 2021.

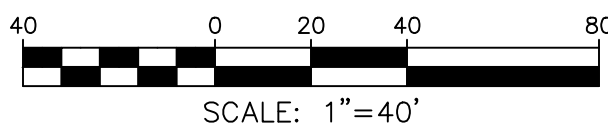

RLA

R LEVESQUE
ASSOCIATES INC.

Landscape Architects
Civil Engineers - Land Surveyors
Environmental Consultants

ph: 413.568.0985 fax: 413.568.0986

40 School Street
Westfield, MA 01085
rland.com

"AS-BUILT" PLAN
Redstone Drive

36 Redstone Drive - East Longmeadow, MA
Assessors parcel 23/77/0

DRAFT

PREPARED FOR:

Bedrock Financial, LLC
dba Rose Bud Builders
P.O. Box 79
East Longmeadow, MA

ISSUANCE DATE: March 24, 2022

REVISIONS: DATE:



UNAUTHORIZED ALTERATION OF
THIS DOCUMENT IS A VIOLATION
OF MASSACHUSETTS STATE LAW

SCALE: AS NOTED

RLA PROJ. NUMBER: 171109

DRAWING# REV.

AB-1 -

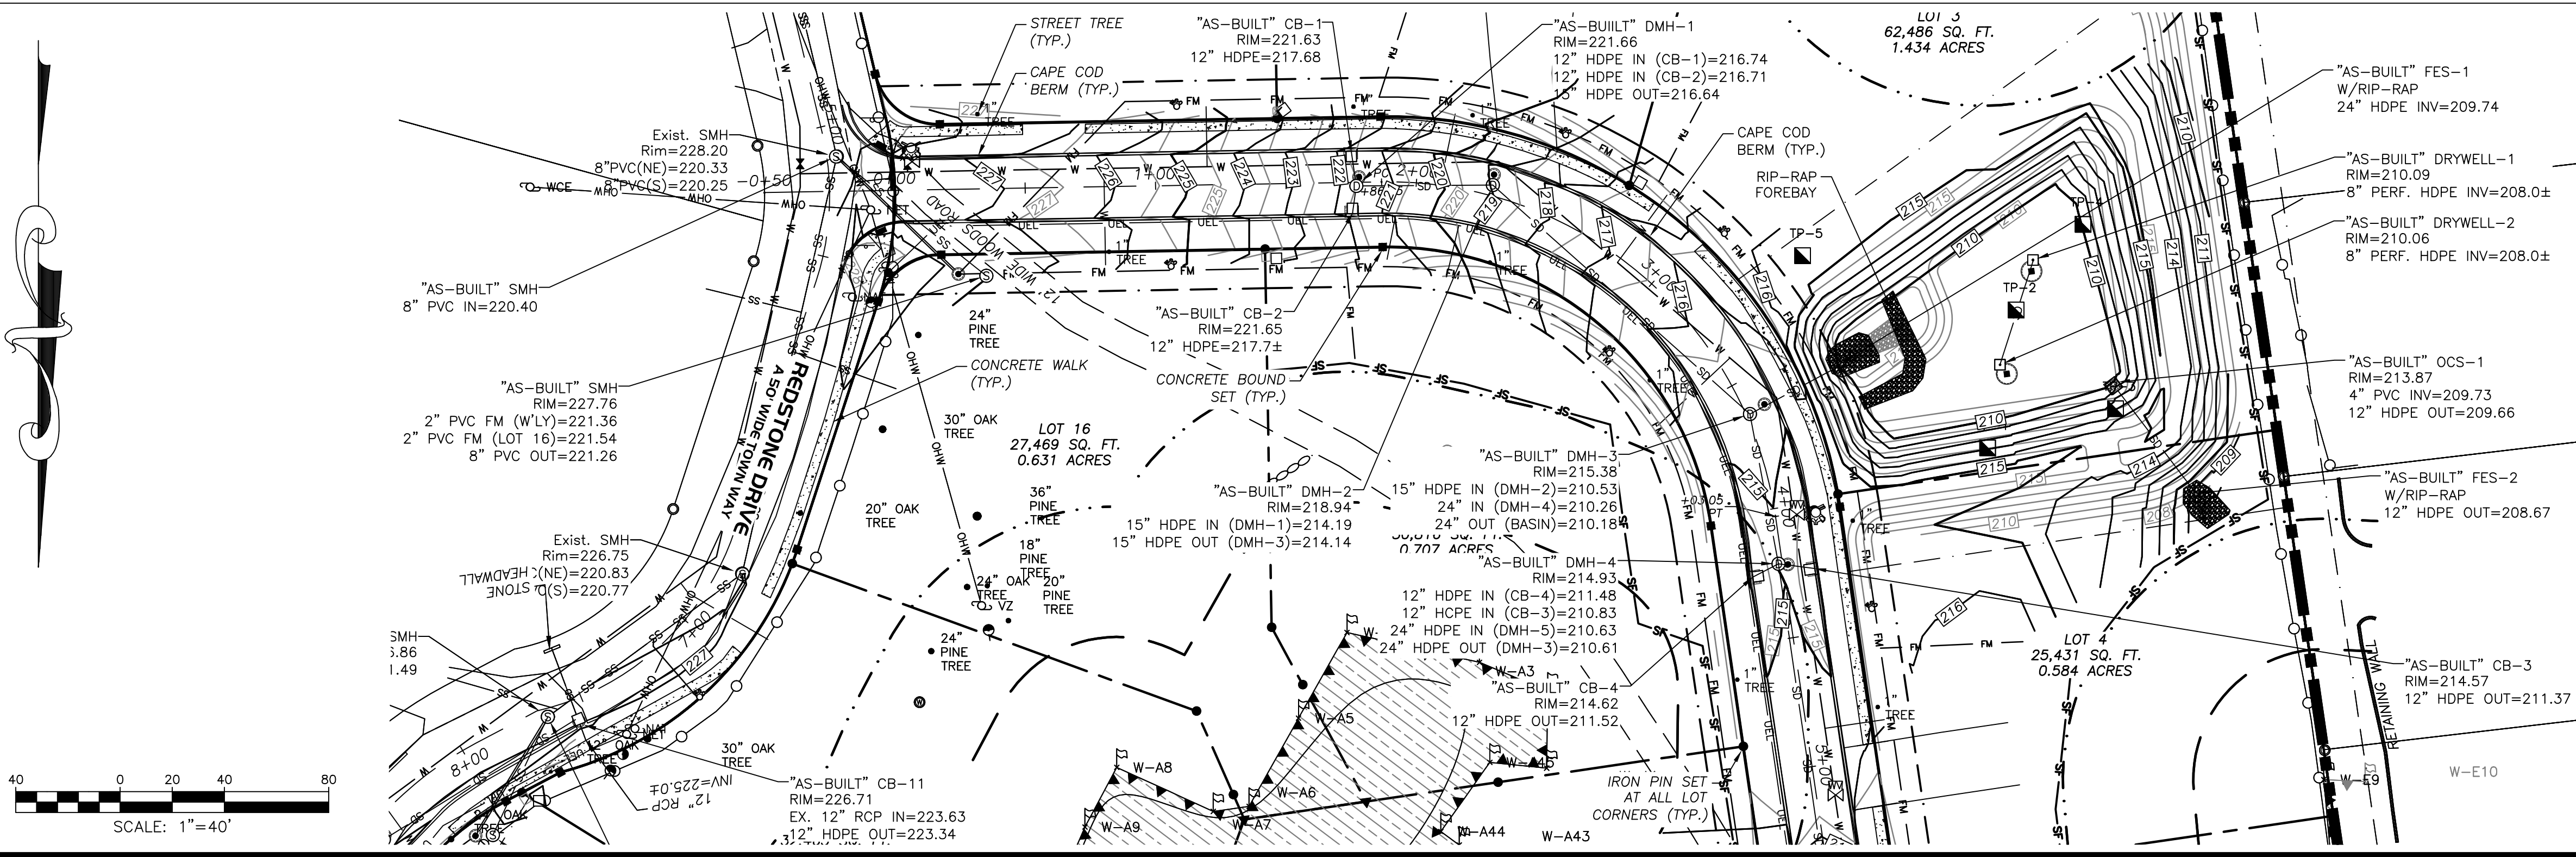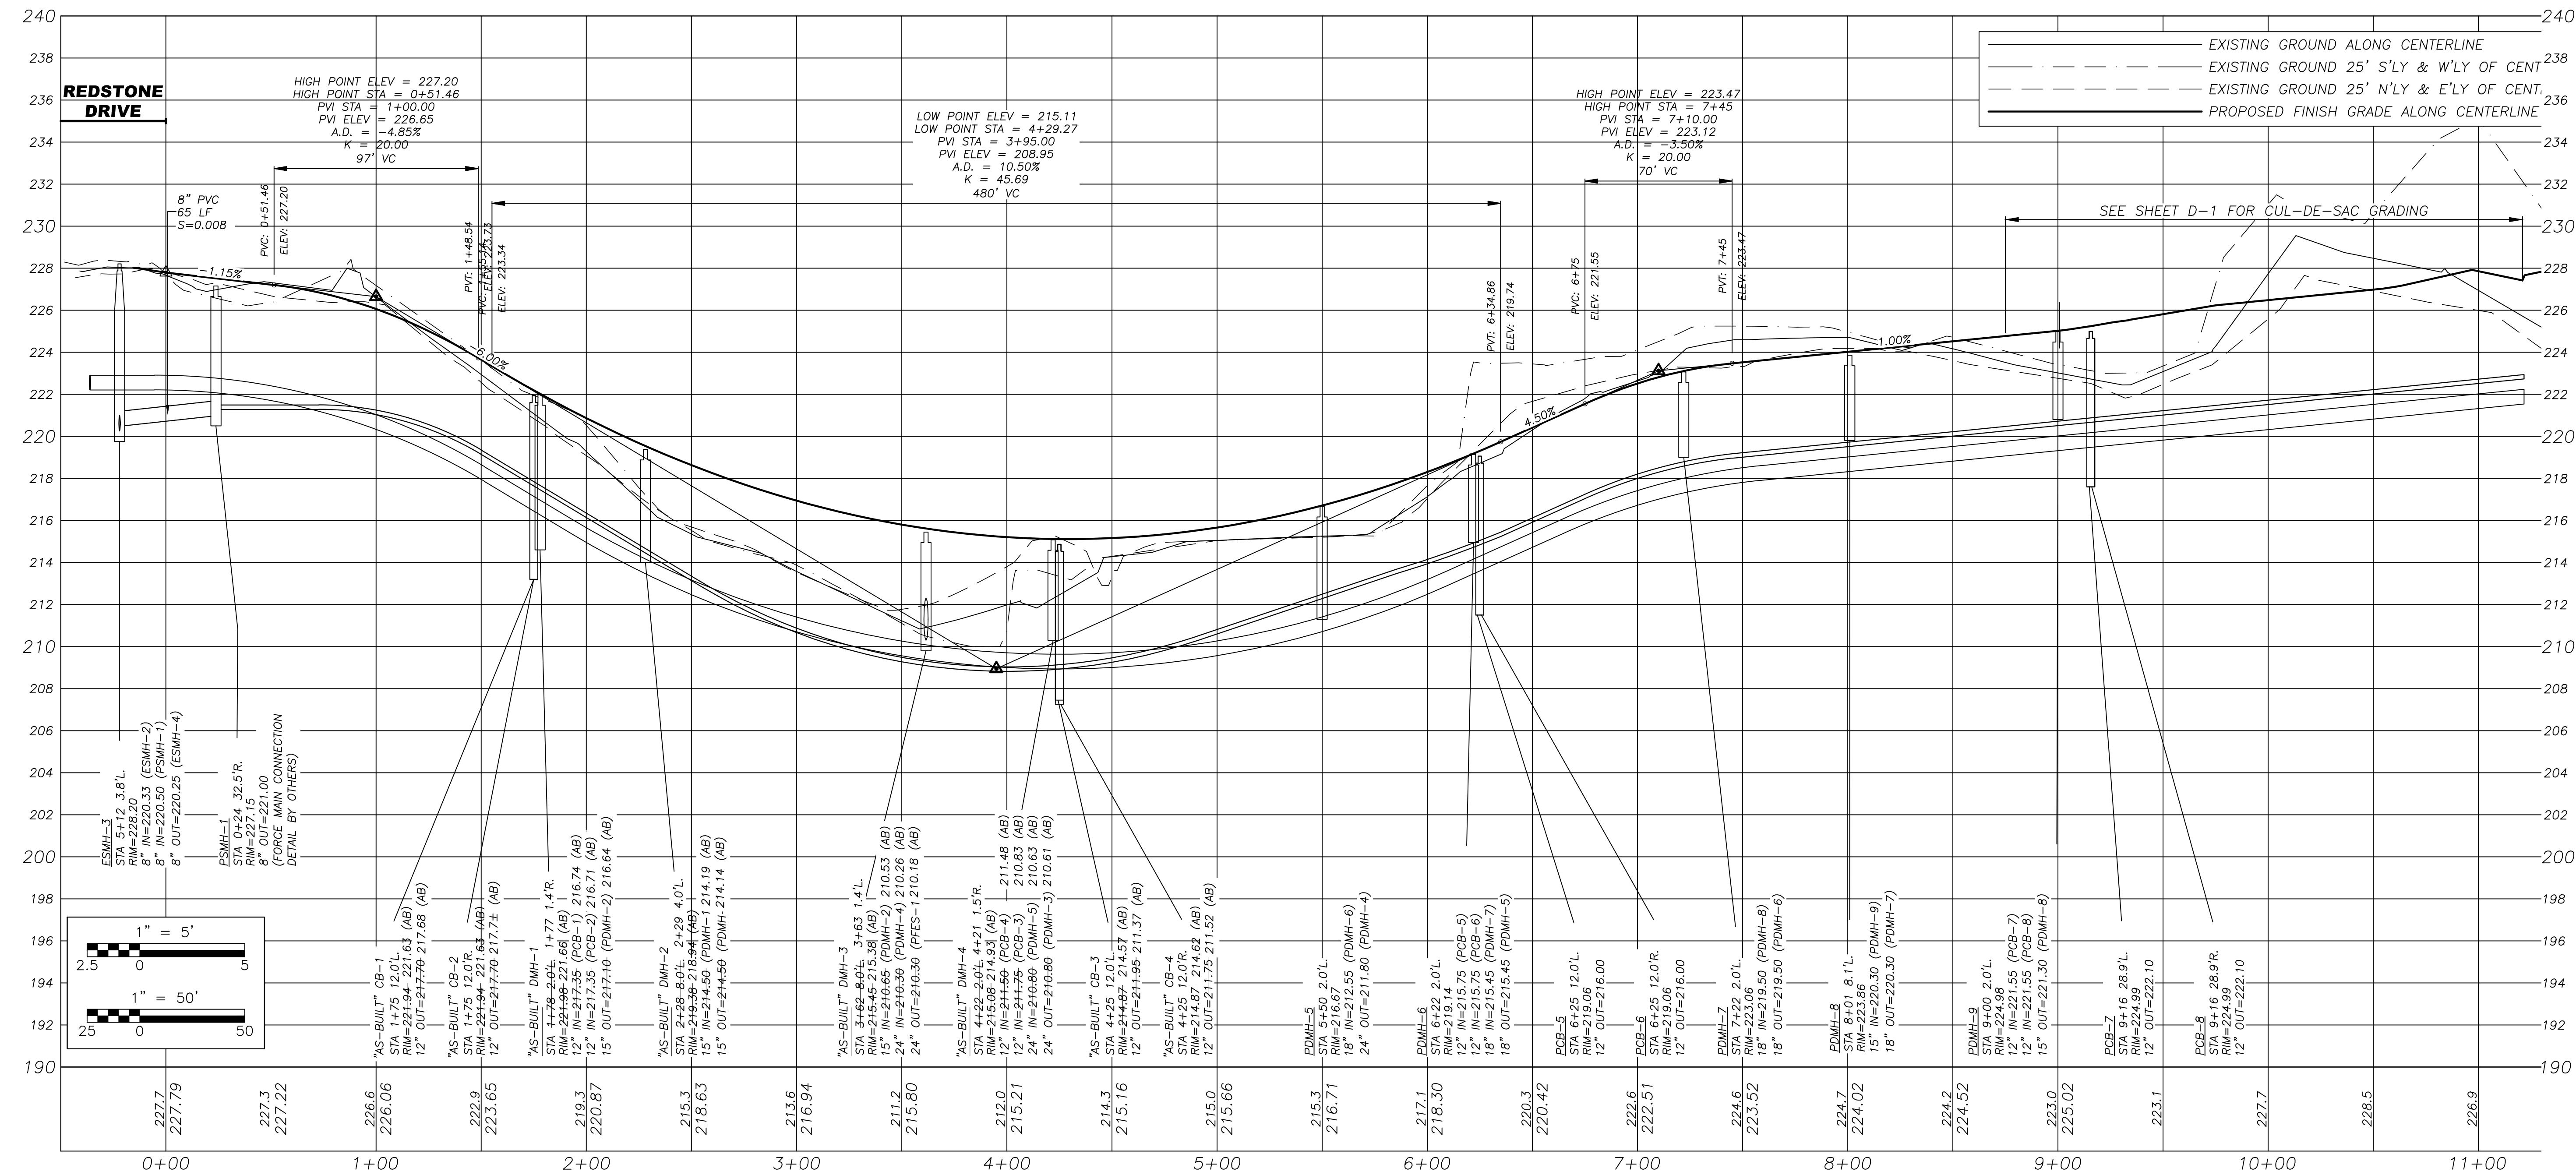

NOTES

1. THE SUBDIVISION DEVELOPER IS BEDROCK FINANCIAL, LLC D/B/A ROSE BUD BUILDERS.
2. FOR DEFINITIVE SUBDIVISION PLANS SEE HAMPDEN COUNTY REGISTRY OF DEEDS PLAN BOOK 385 PAGES 33-34.
3. THIS PLAN HAS BEEN PREPARED FOR SITE PLANNING PURPOSES AND SHALL NOT BE USED FOR THE CONVEYANCE OF LAND OR FOR ANY OTHER USE.
4. "AS-BUILT" SUBDIVISION INFORMATION DEPICTED HEREON IS DERIVED FROM AN ON-GROUND INSTRUMENT SURVEY BY R LEVESQUE ASSOCIATES, INC. PERFORMED BETWEEN JULY 19 AND OCTOBER 5, 2021.

RLA
R LEVESQUE ASSOCIATES INC.
Landscape Architects
Civil Engineers - Land Surveyors
Environmental Consultants
ph: 413.568.0985 fax: 413.568.0986
40 School Street
Westfield, MA 01085
rlaland.com

"AS-BUILT" PLAN
Hidden Ponds Drive - Sta. 0+00 - Sta. 5+00
36 Redstone Drive - East Longmeadow, MA
Assessors parcel 23/77/0

DRAFT

PREPARED FOR:

Bedrock Financial, LLC
dba Rose Bud Builders
P.O. Box 79
East Longmeadow, MA

ISSUANCE DATE: March 24, 2022

REVISIONS: DATE:


UNAUTHORIZED ALTERATION OF THIS DOCUMENT IS A VIOLATION OF MASSACHUSETTS STATE LAW

SCALE: AS NOTED



RLA PROJ. NUMBER: 171109

DRAWING# REV.

AB-2

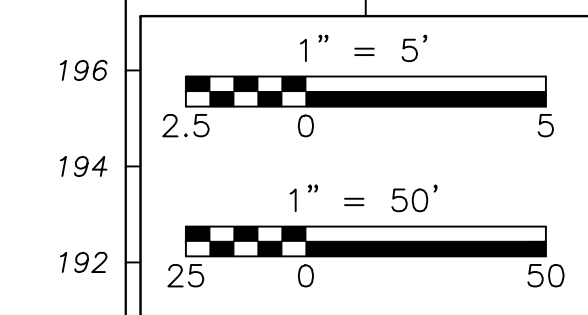

- NOTES
1. THE SUBDIVISION DEVELOPER IS BEDROCK FINANCIAL, LLC D/B/A ROSE BUD BUILDERS.
 2. FOR DEFINITIVE SUBDIVISION PLANS SEE HAMPDEN COUNTY REGISTRY OF DEEDS PLAN BOOK 385 PAGES 33-34.
 3. THIS PLAN HAS BEEN PREPARED FOR SITE PLANNING PURPOSES AND SHALL NOT BE USED FOR THE CONVEYANCE OF LAND OR FOR ANY OTHER USE.
 4. "AS-BUILT" SUBDIVISION INFORMATION DEPICTED HEREON IS DERIVED FROM AN ON-GROUND INSTRUMENT SURVEY BY R LEVESQUE ASSOCIATES, INC. PERFORMED BETWEEN JULY 19 AND OCTOBER 5, 2021.

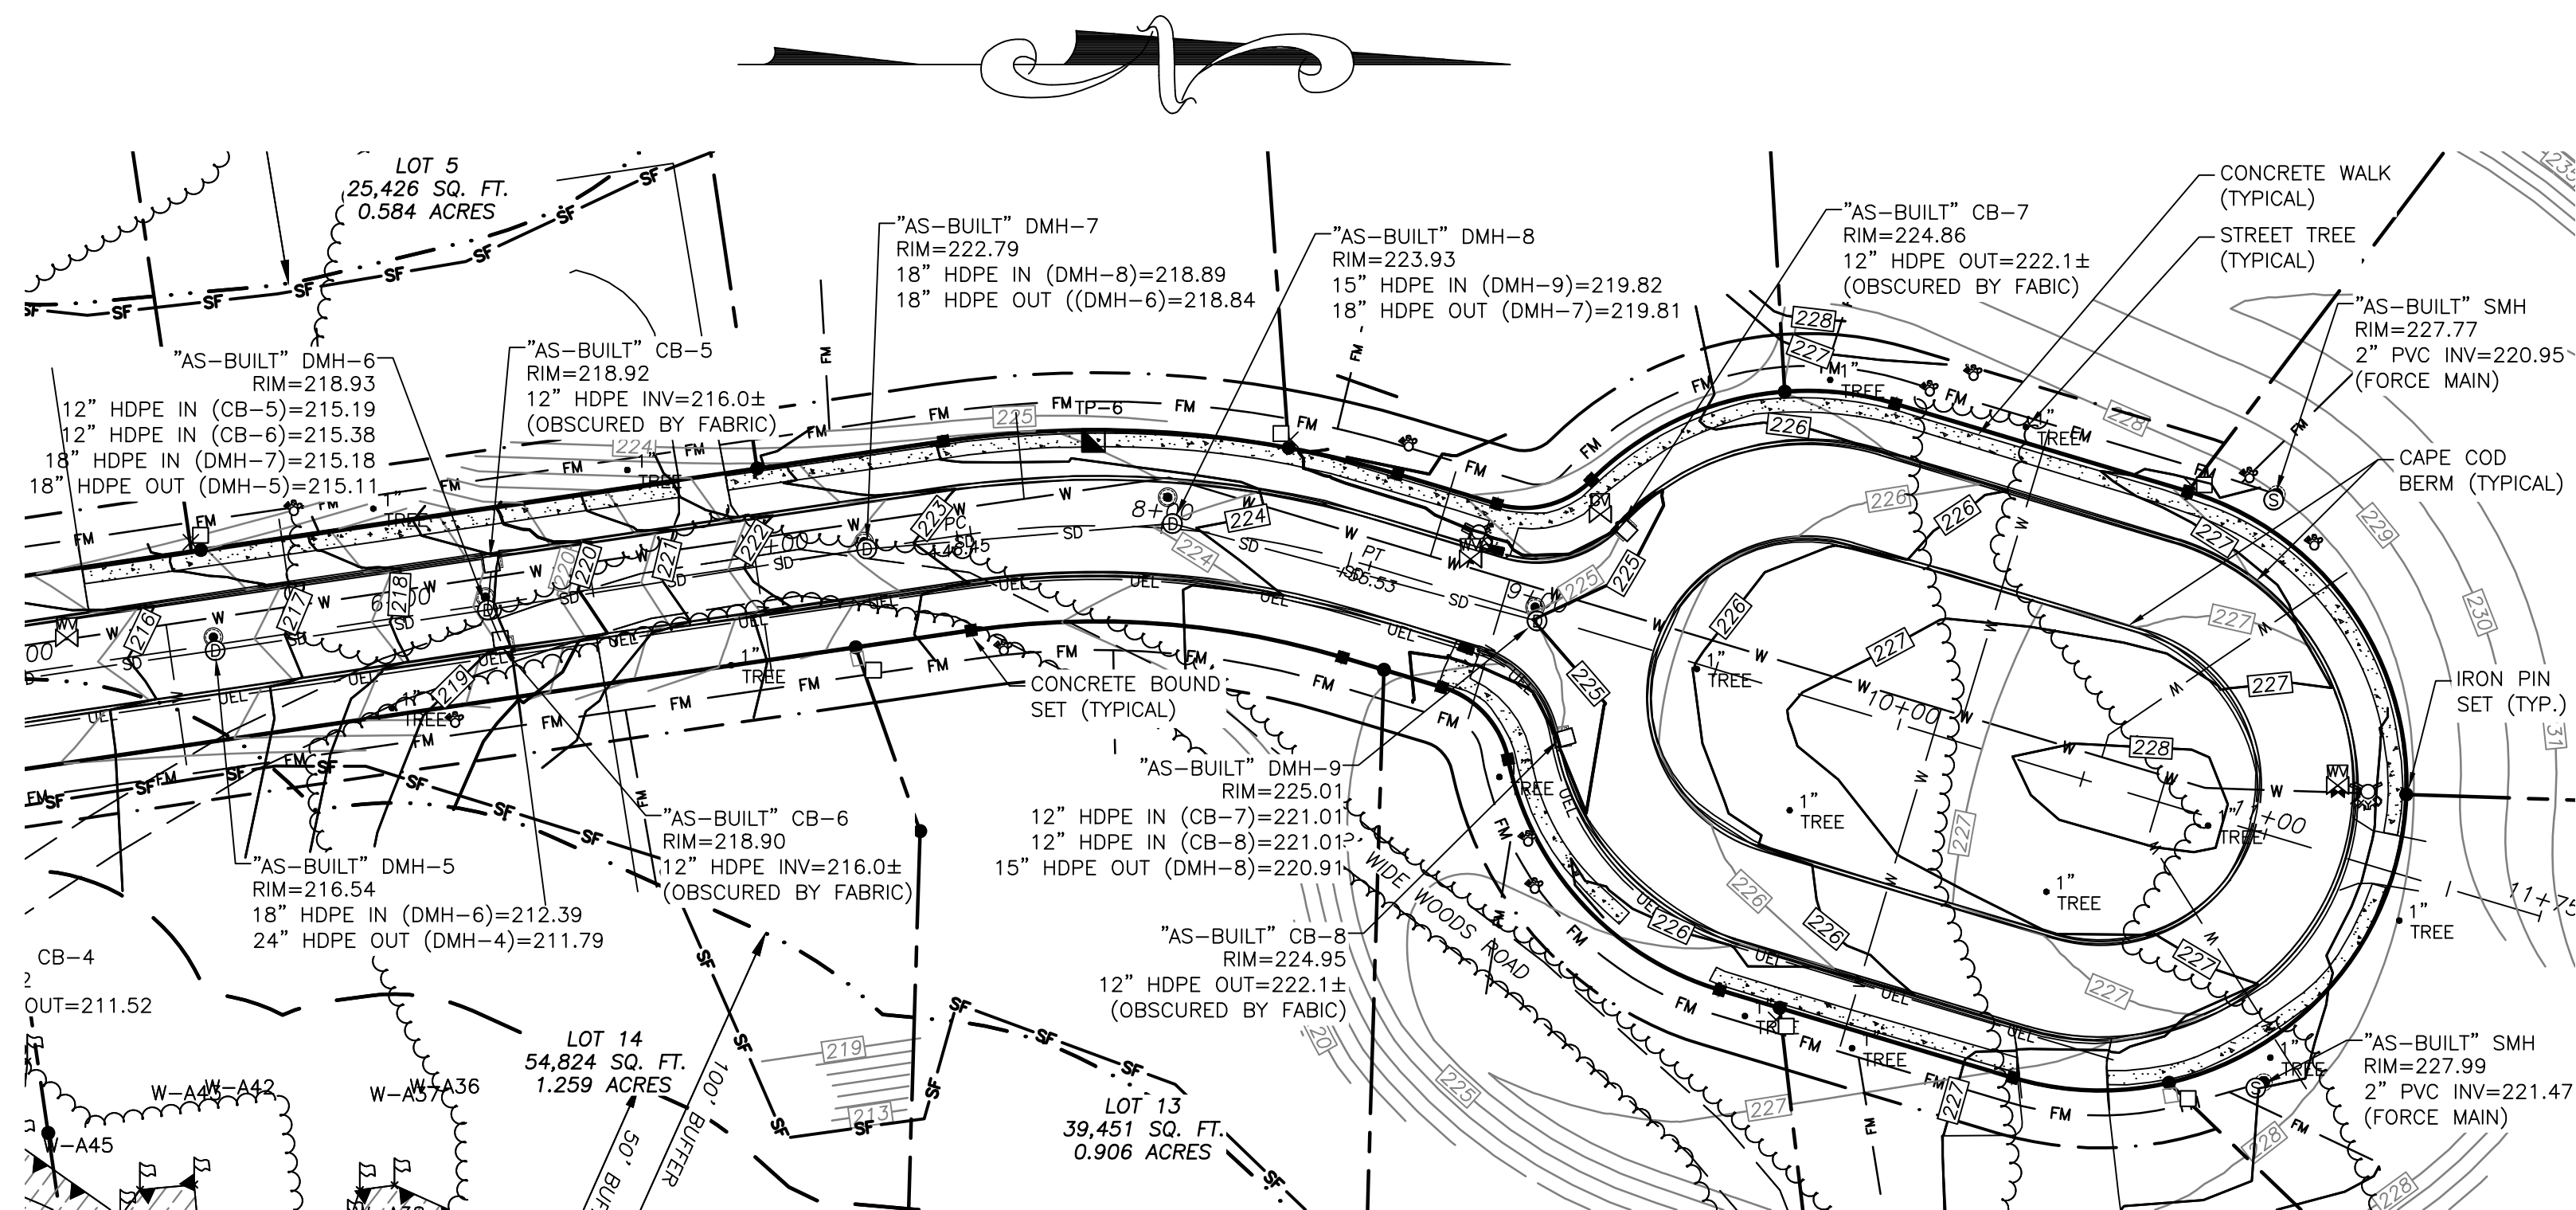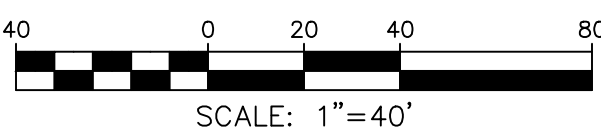

"AS-BUILT" PLAN
Hidden Ponds Drive - Sta. 5+00 - Sta. 11+00

36 Redstone Drive - East Longmeadow, MA
Assessors parcel 23/77/O

DRAFT

PREPARED FOR:

Bedrock Financial, LLC
dba Rose Bud Builders
 P.O. Box 79
 East Longmeadow, MA

ISSUANCE DATE: March 24, 2022

REVISIONS:	DATE:

UNAUTHORIZED ALTERATION OF
 THIS DOCUMENT IS A VIOLATION
 OF MASSACHUSETTS STATE LAW

SCALE: AS NOTED

RLA PROJ. NUMBER: 171109

DRAWING#	REV.
AB-3	-