



KEYWAY AND DRIVEWAY APRON DETAIL

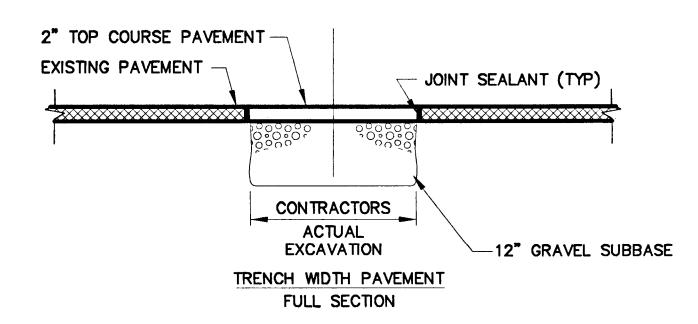


TEMPORARY PAVEMENT REPLACEMENT DETAIL

N.T.S.

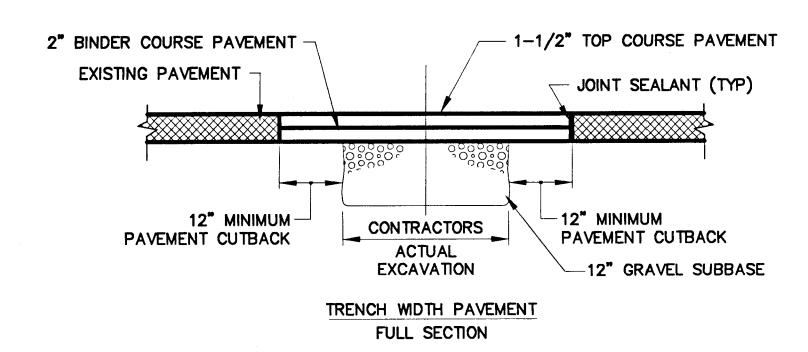


PERMANENT PAVEMENT REPLACEMENT

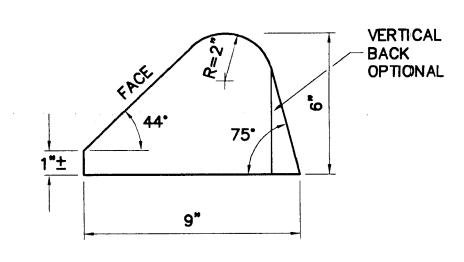

CURB DETAIL


CURB IS TYPE=2 PER MASS.

DPW CONSTRUCTION STANDARDS

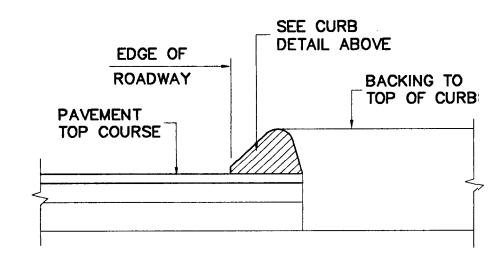

BITUMINOUS CONCRETE CURB

N.T.S.

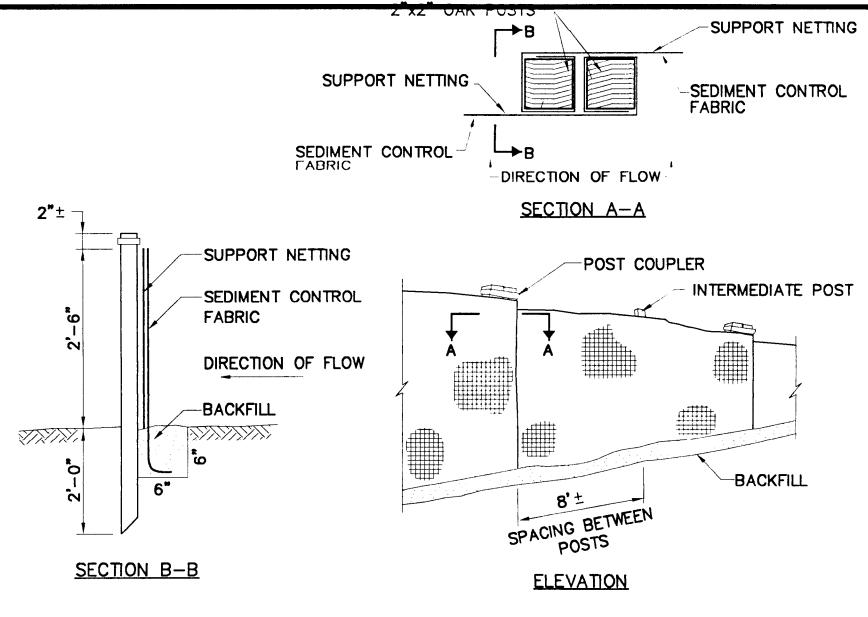


SILT FENCE DETAIL

-BALED HAY


OR STRAW

-BALES TO BUTT


TOGETHER

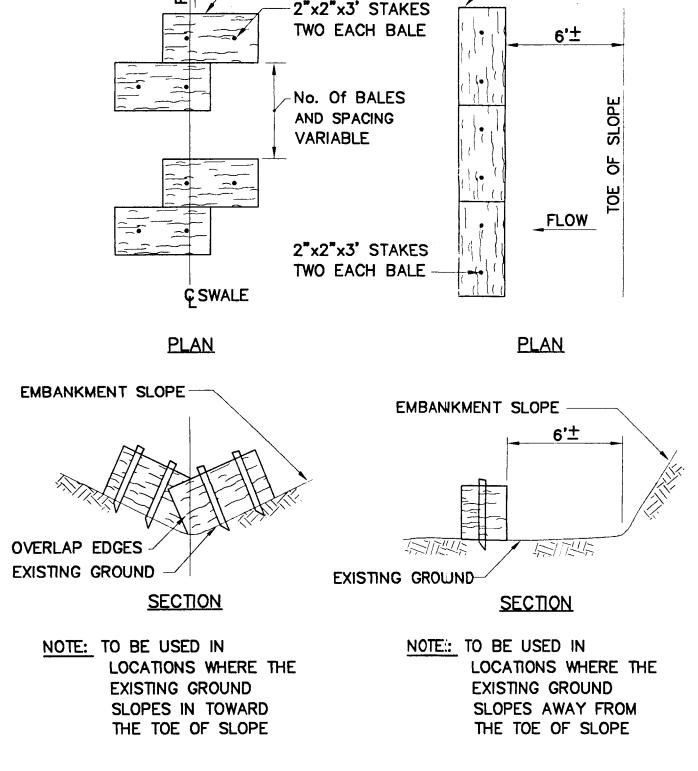


HAY BALES DETAIL N.T.S.

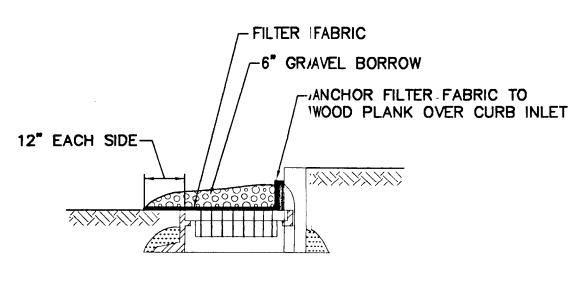


CATCH BASIN INLET PROTECTION DETAIL
N.T.S.

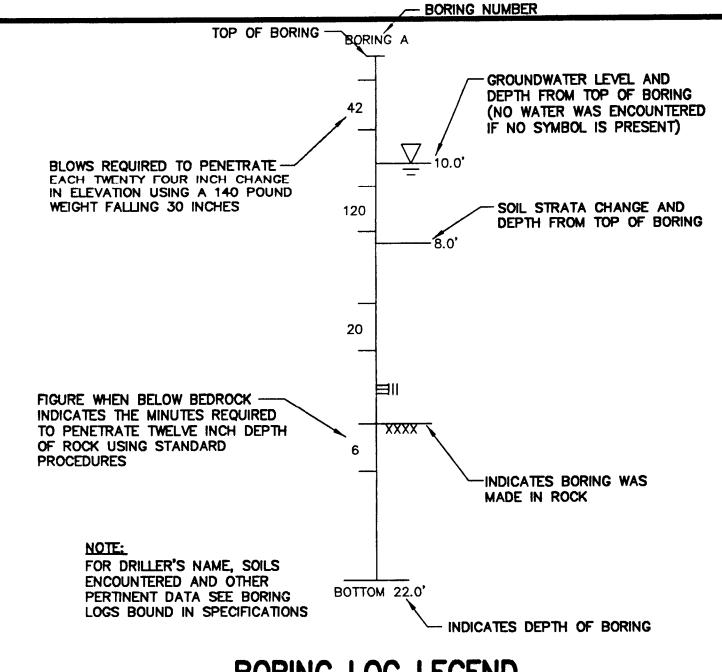

BORING LOG LEGEND
N.T.S.

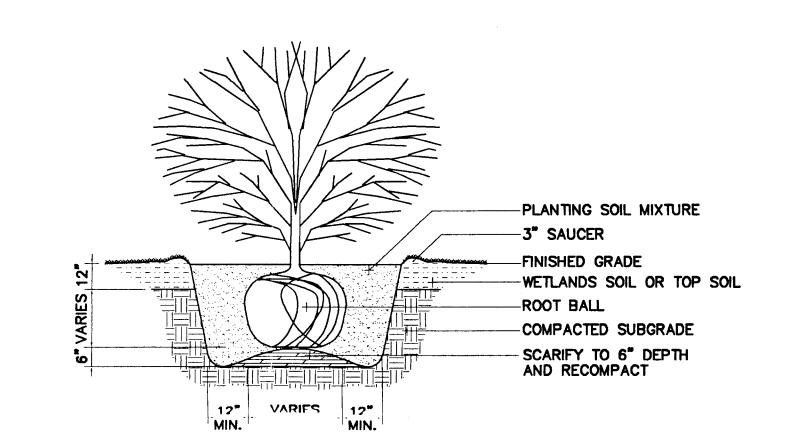

SHRUB PLANTING

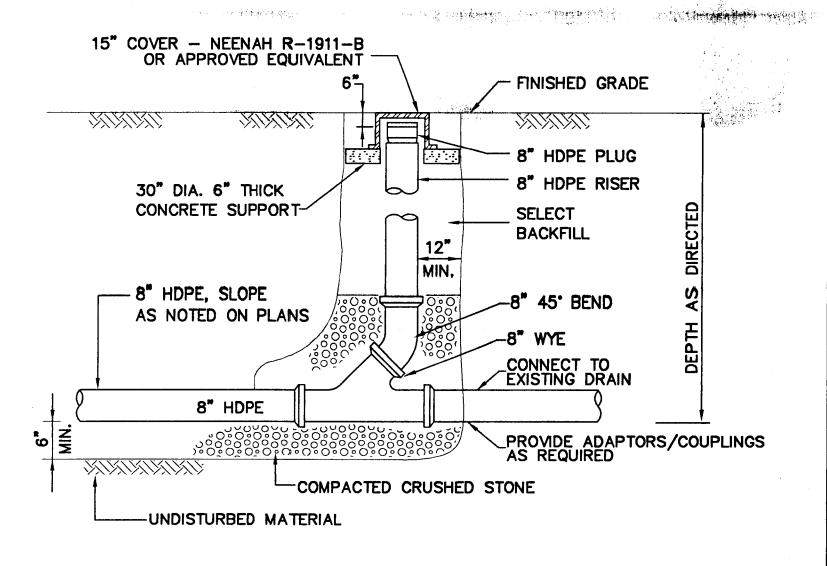

DRAIN LINE CLEANOUT DETAIL

RECORD DRAWING

	Weston & Sampson		Five Centennial Drive Peobody, MA 01960	
	2/05 WGS DRL RECORD DR	No. Date Dr.By Ck.By App.By Description A P P R O V E D		REGISTERED PROFESSIONAL ENGINEER
TOWN OF EAST LONGMEADOW, MASSACHUSETTS BOARD OF PUBLIC WORKS	REDSTONE DRIVE SEWER AND WATER IMPROVEMENTS AND MISCELLANEOUS DRAINAGE IMPROVEMENT PROJECTS	DETALS		R-REDSTONE AS NOTED CONTRACT: 201321 WGS WGS DRL PMS
L			7	43–1