
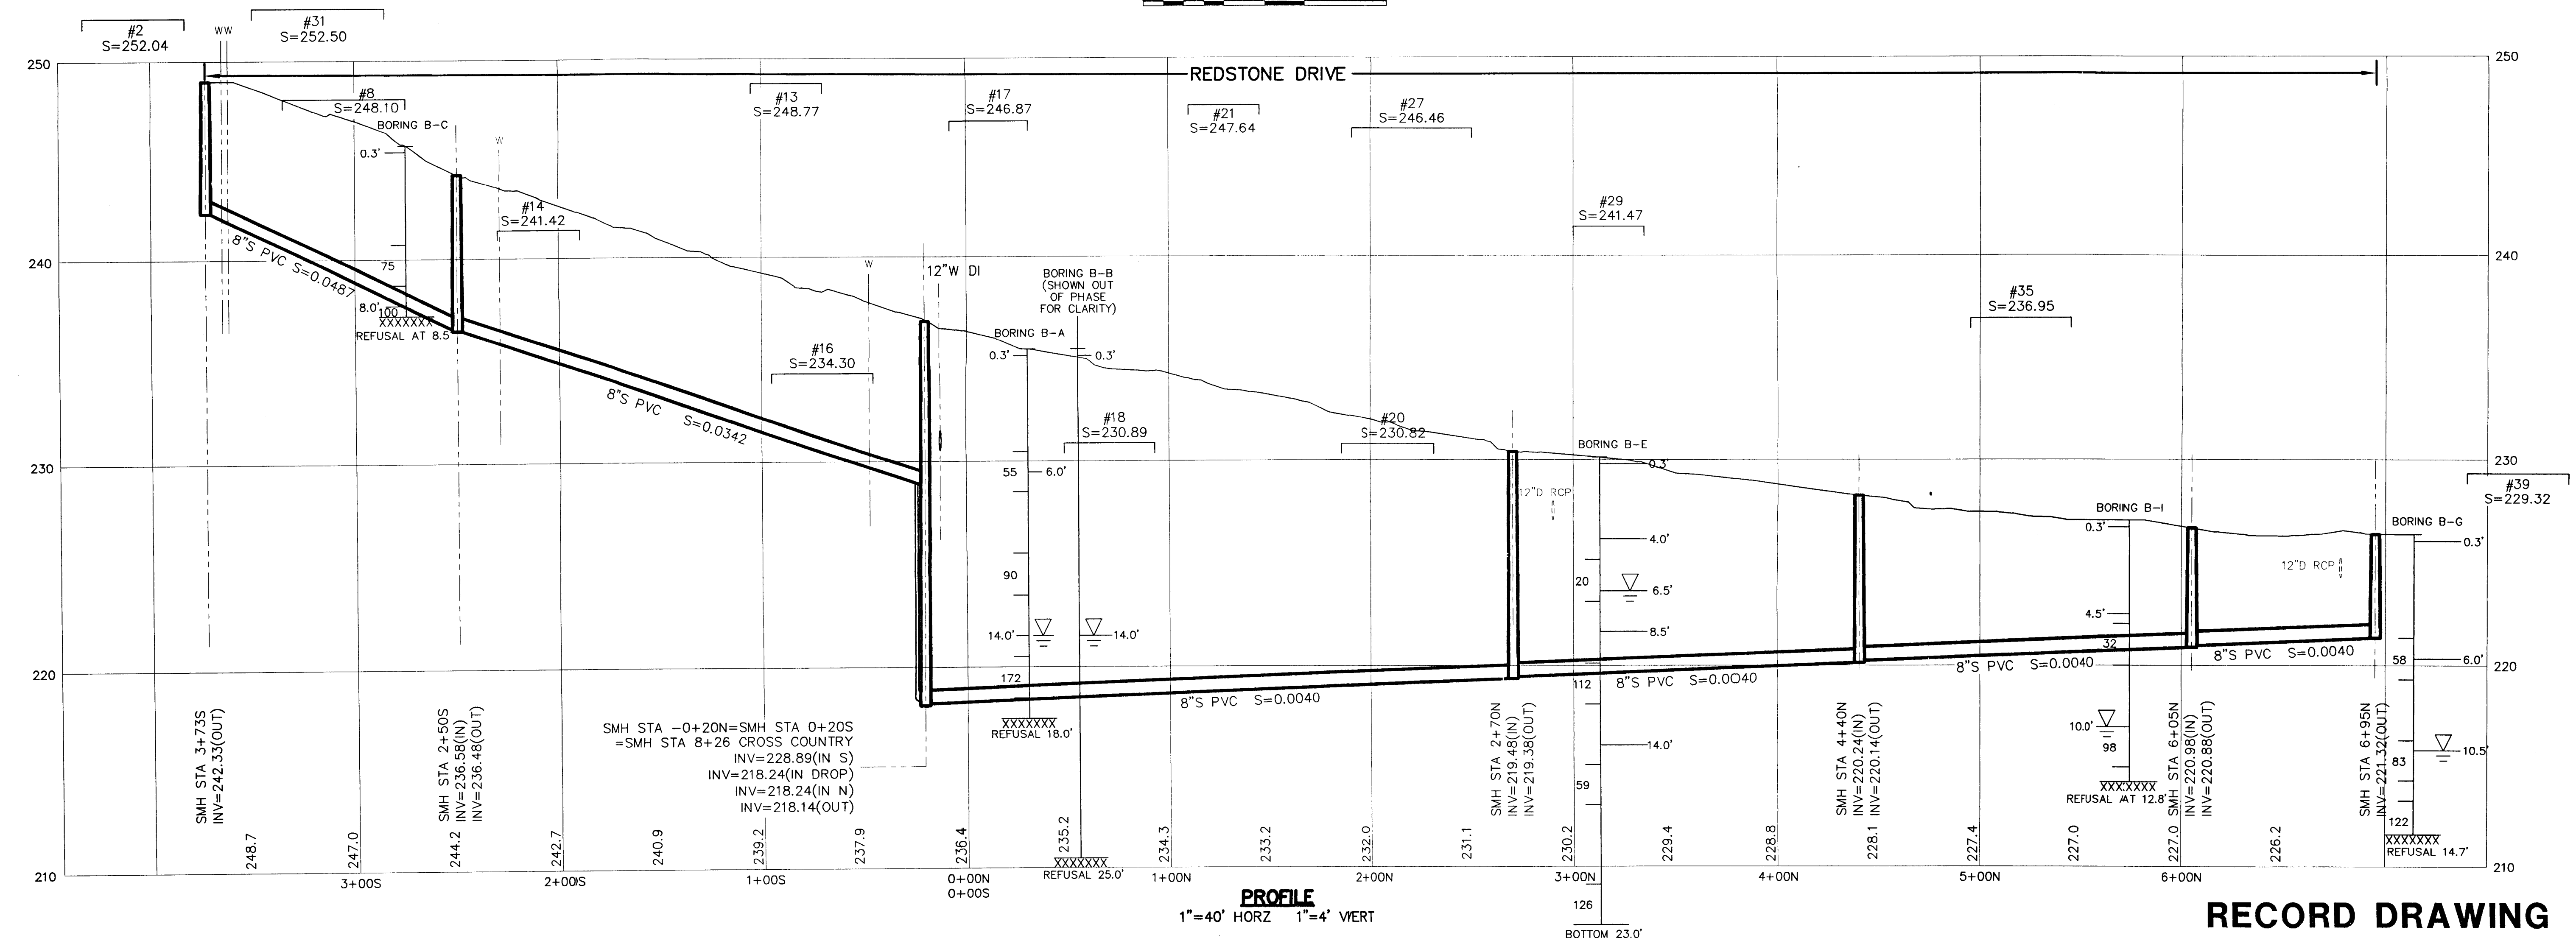


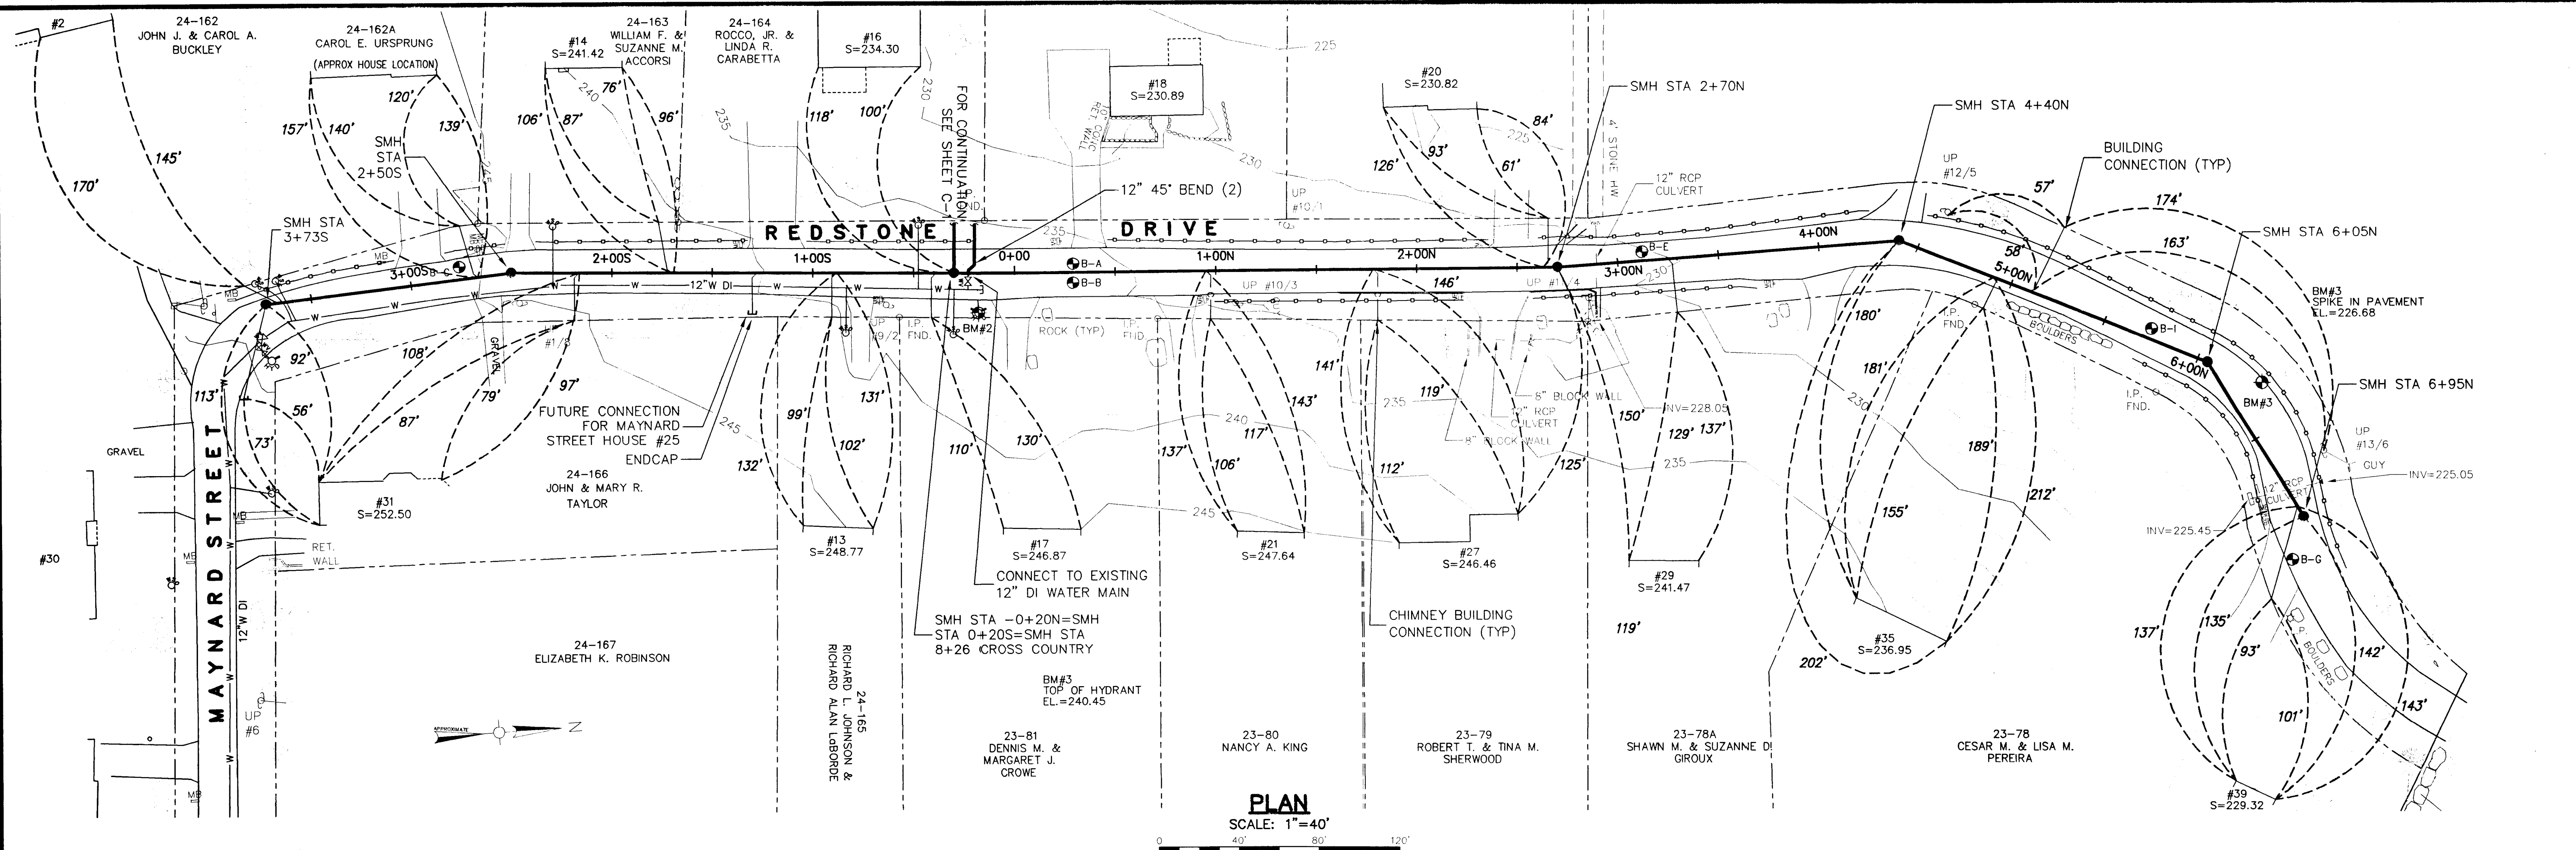

Weston & Sampson
ENGINEERS, INC.

Five Centennial Drive, Peabody, MA 01960

2	2/05	WGS	DRL	RECORD DRAWING
1	9/03 <td>WGS<td>DRL<td>SEWER AND WATER ALIGNMENT</td></td></td>	WGS <td>DRL<td>SEWER AND WATER ALIGNMENT</td></td>	DRL <td>SEWER AND WATER ALIGNMENT</td>	SEWER AND WATER ALIGNMENT
No. Date		Dr. By	Ch. By	App. By

REGISTERED PROFESSIONAL ENGINEER

DATE

TOWN OF EAST LONGMEADOW, MASSACHUSETTS
BOARD OF PUBLIC WORKS

REDSTONE DRIVE SEWER AND WATER IMPROVEMENTS AND
MISCELLANEOUS DRAINAGE IMPROVEMENT PROJECTS

REDSTONE DRIVE STA -0+20N TO 6+95N
REDSTONE DRIVE STA 0+20S TO 3+73S

C-2

FILE NO. 143-4

SCALE: 1"=40'

CONTRACT

JOB NO. 201321

DATE

WGS

DRL

PMS