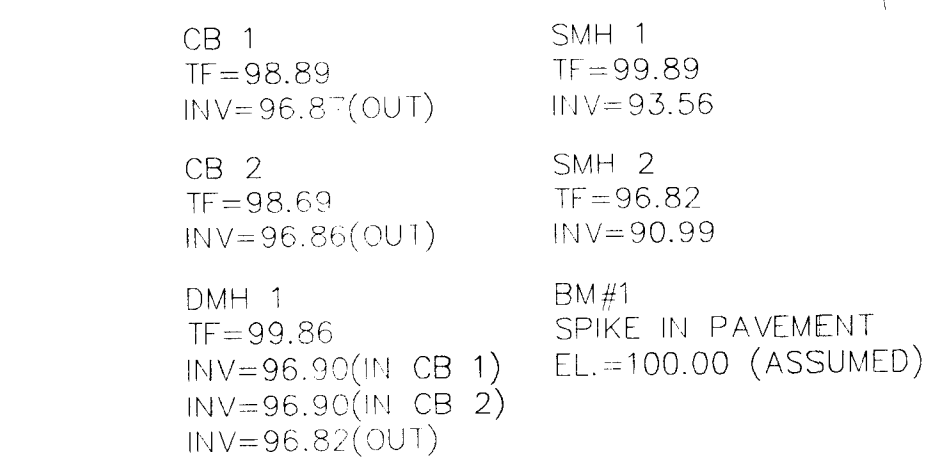


BM#1	CB 2	SMH 1
SPIKE IN PAVEMENT	TF=265.19	TF=264.55
EL.=264.56	INV=260.19 (IN 4" PVC)	INV=254.58 (IN)
	INV=260.11 (IN CB 3)	INV=254.48 (OUT)
RM#2	INV=259.94 (OUT CB 4)	
TOP OF HYDRANT	INV=259.84 (OUT 12" RCP)	SMH 2
EL.=269.08		TF=267.11
	CB 3	INV=259.44 (IN)
CB 1	TF=265.05	INV=259.34 (OUT)
TF=263.36	INV=260.55 (IN 4" PVC)	
INV=258.76 (IN CB 2)	INV=260.11 (OUT 12" RCP)	DMH 1
INV=258.66 (OUT 12" RCP)		TF=268.76
		INV=263.7± (OUT)

1	2/05	WGS	DRL	RECORD DRAWING			
No.	Date	Dr By	Ck By	Description			
		A	P	C	C	V	D
				REGISTERED PROFESSIONAL ENGINEER			
				DATE			

EAST VILLAGE ROAD AND MOUNTAINVIEW ROAD