


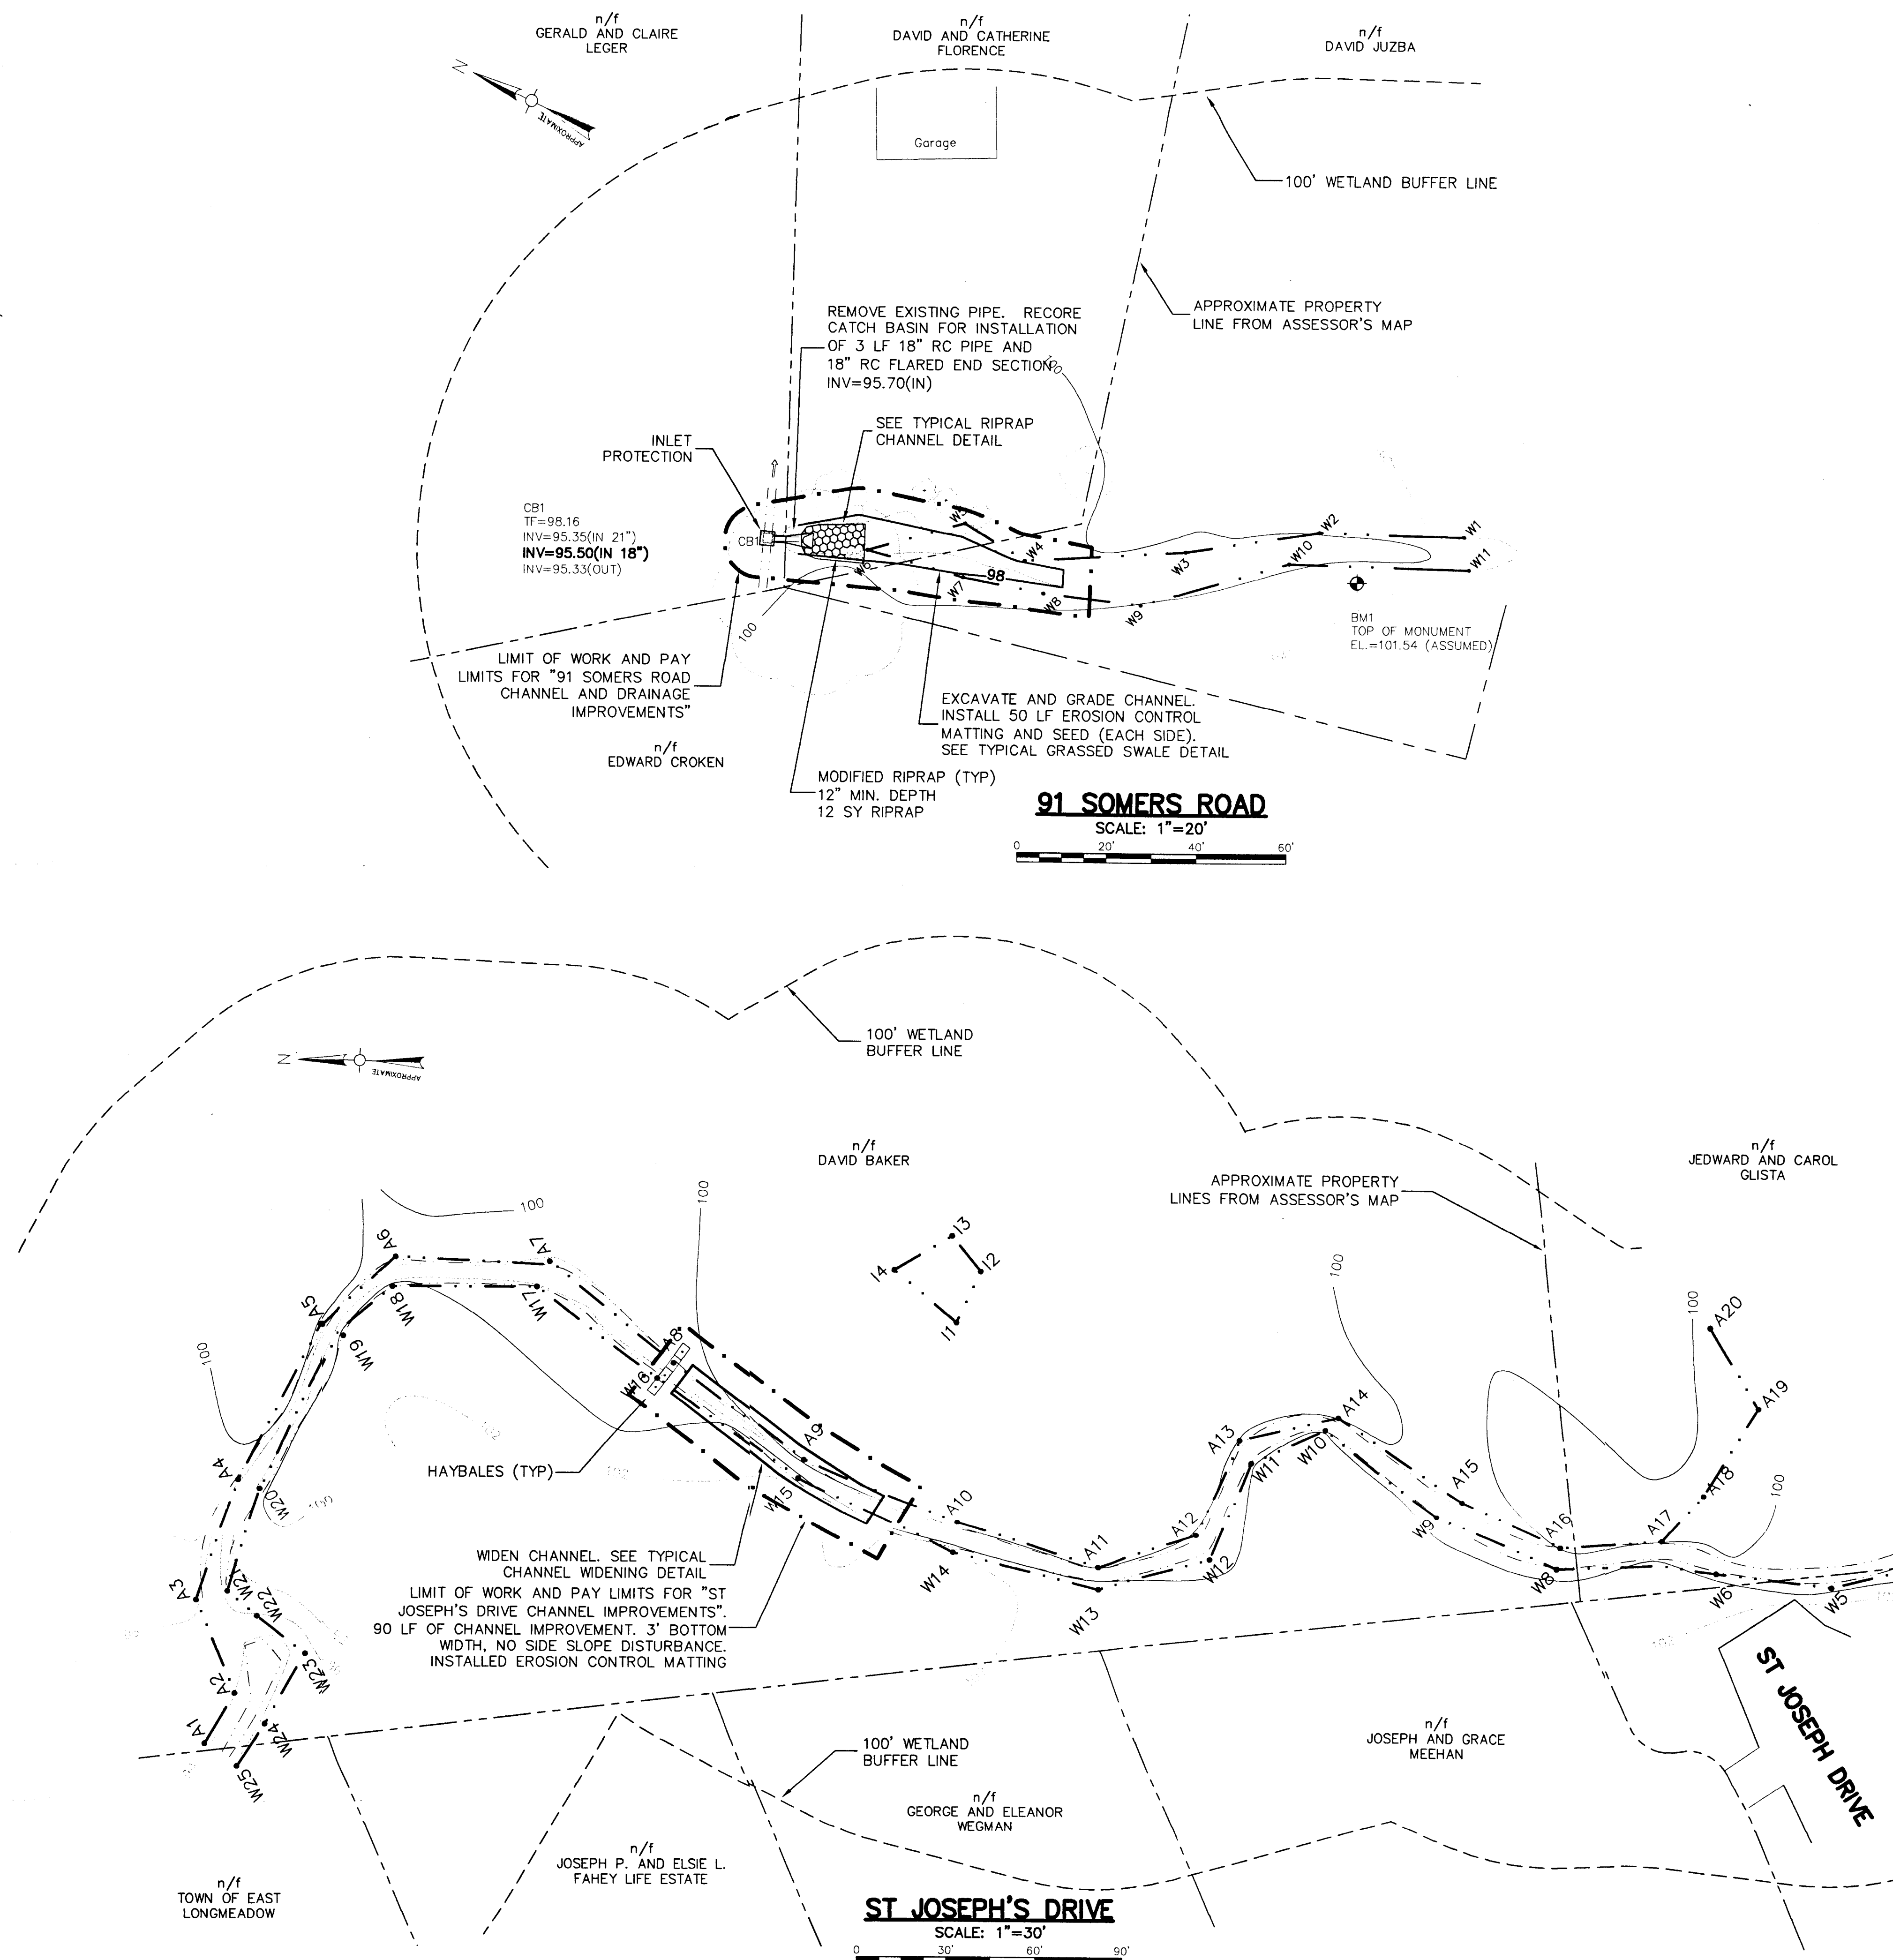

RECORD DRAWING

Weston & Sampson
ENGINEERS, INC.

Five Centennial Drive, Peabody, MA 01960

RECORD DRAWING		Description	
No.	Date	App. By	Dr. By
1	2/05	WGS	DRL

A P P R O V E D

REGISTERED PROFESSIONAL ENGINEER

DATE

TOWN OF EAST LONGMEADOW, MASSACHUSETTS
BOARD OF PUBLIC WORKS

REDSTONE DRIVE SEWER AND WATER IMPROVEMENTS AND
MISCELLANEOUS DRAINAGE IMPROVEMENT PROJECTS

91 SOMERS ROAD AND ST JOSEPH'S DRIVE

FILE NO.	CADD NO.	SCALE	CO. DATE	JOB NO.	DR. BY	CHK. BY	APP. BY
143-4B	R-REDSTONE	AS NOTED		201321	WGS	WGS	PMS