


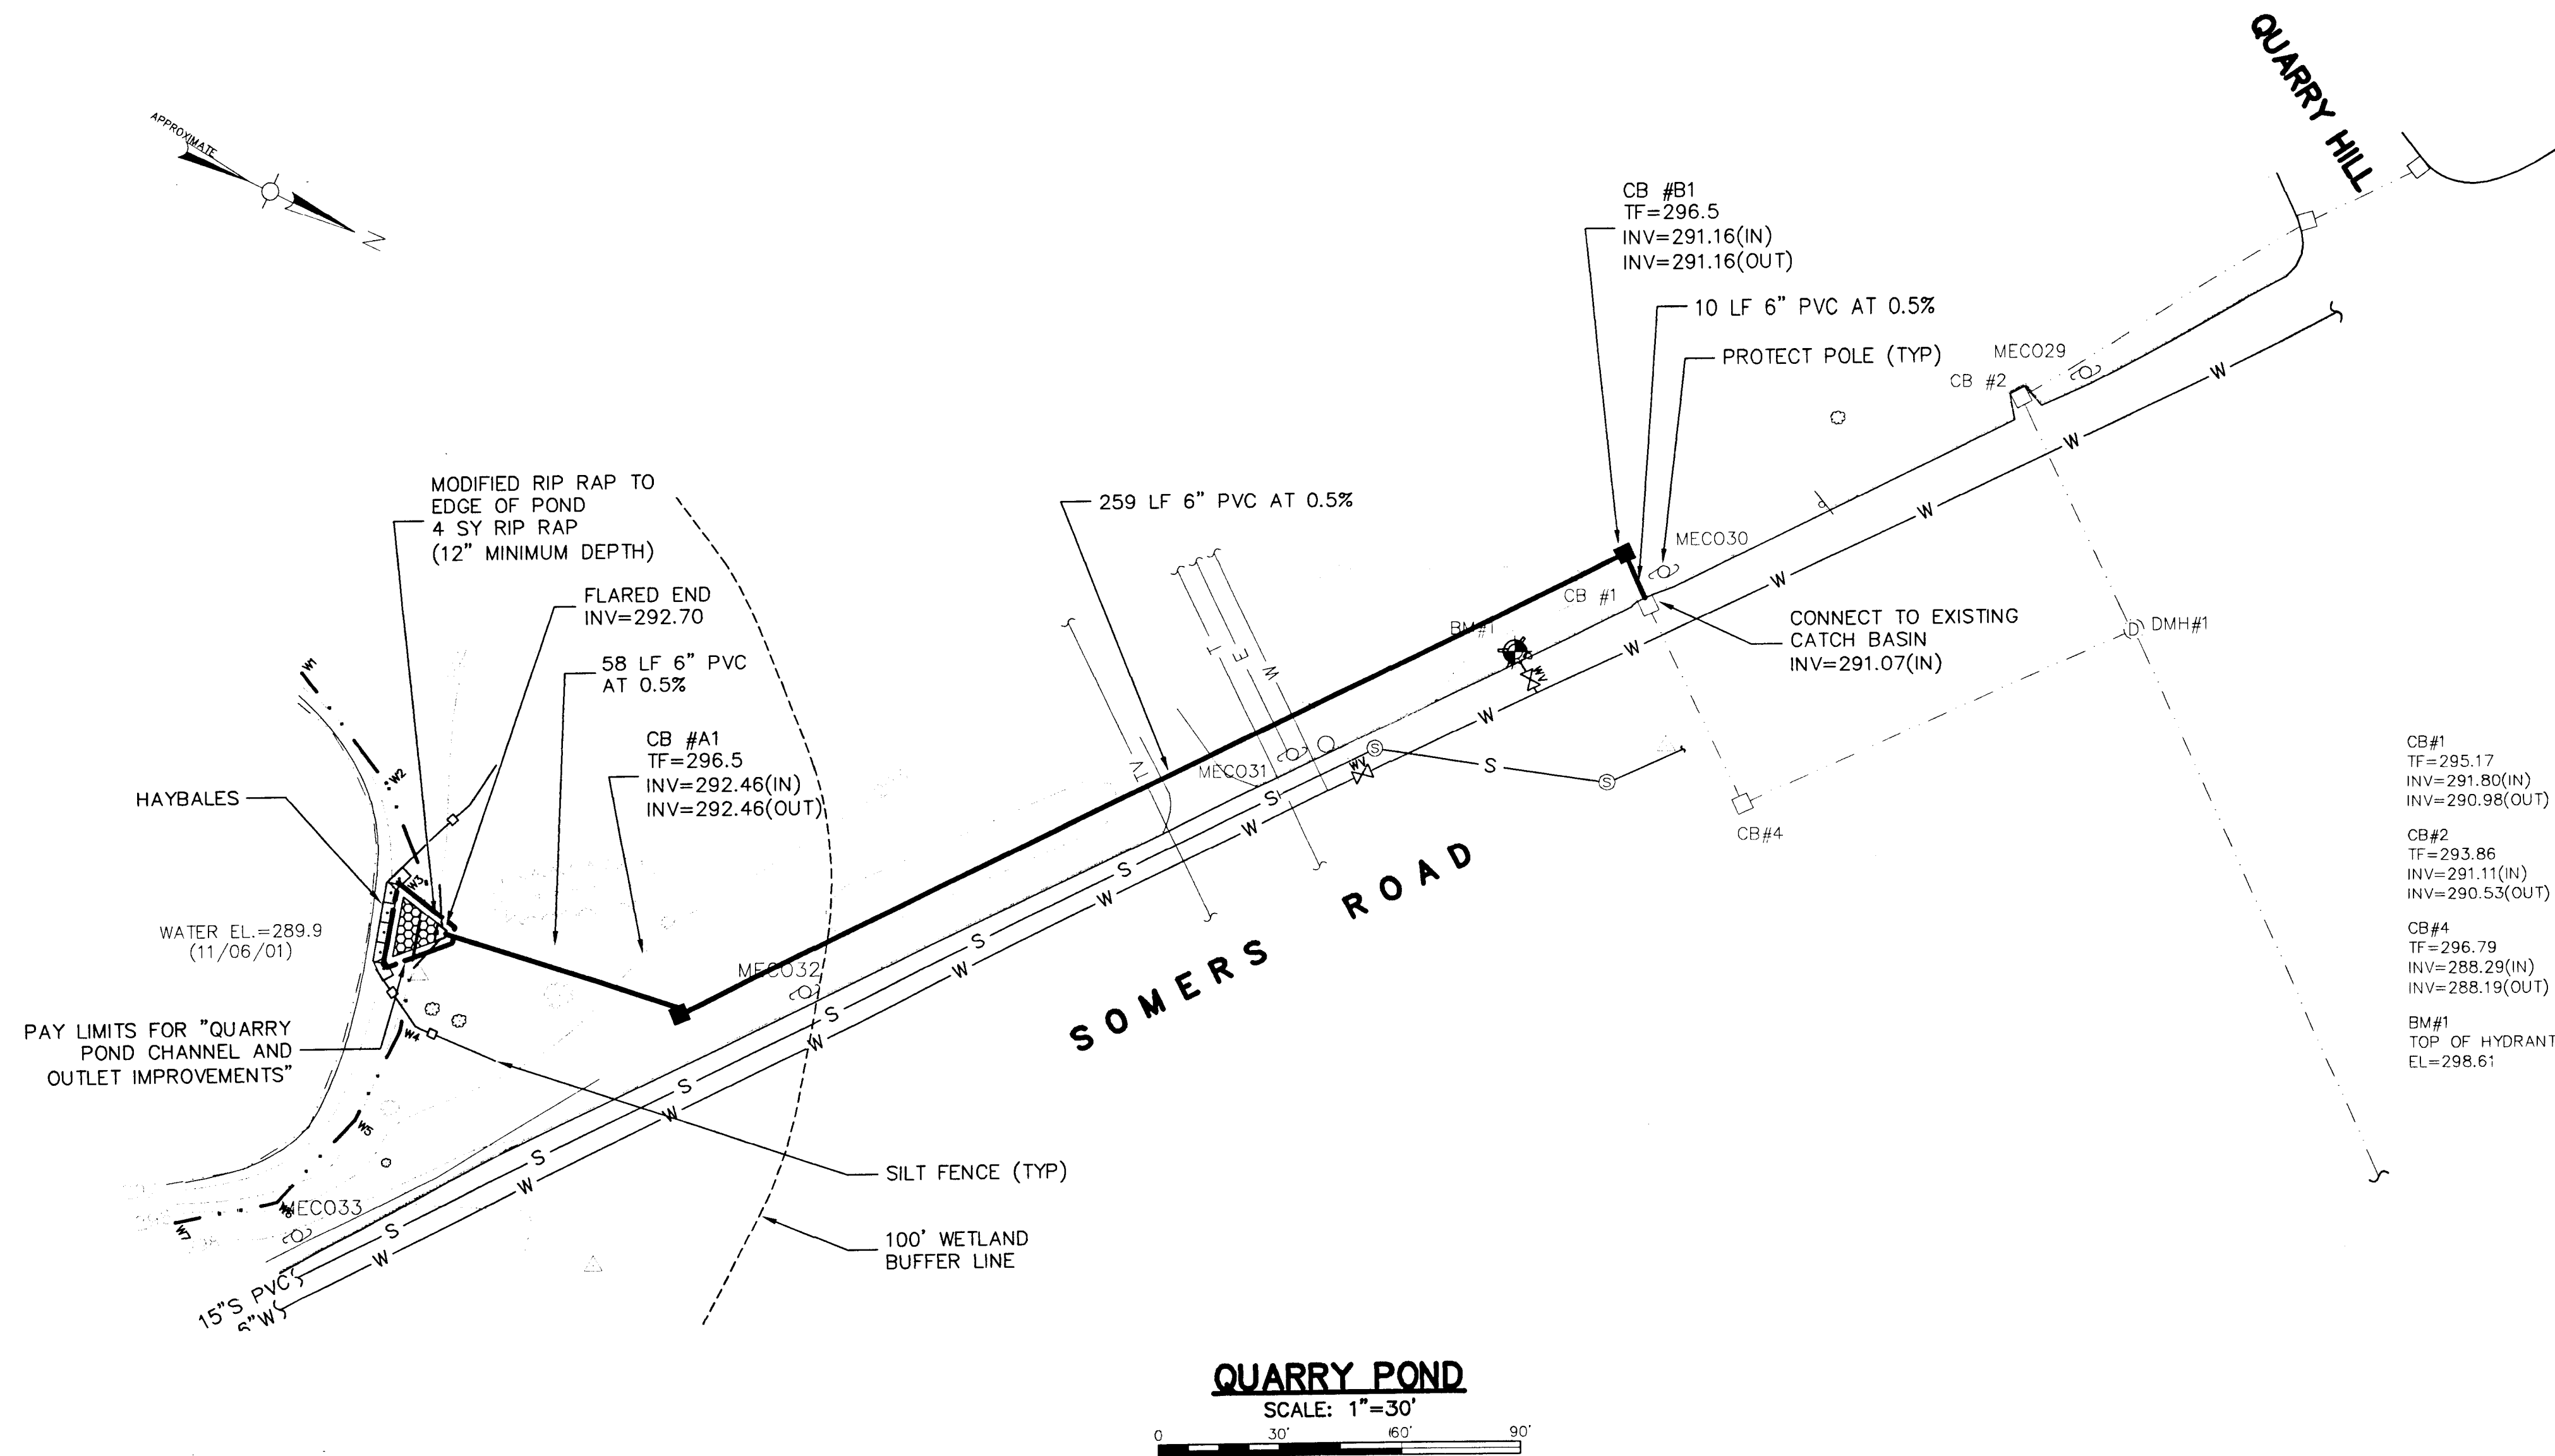

QUARRY POND
SCALE: 1"=30'



RECORD DRAWING

Weston & Sampson
ENGINEERS, INC.

Five Centennial Drive, Peabody, MA 01960

RECORD DRAWING		Description	
No.	Date	Dr. By	App. By
1	2/05	WGS	DRL
		A	P
		R	O
		V	E
		D	

REGISTERED PROFESSIONAL ENGINEER

TOWN OF EAST LONGMEADOW, MASSACHUSETTS
BOARD OF PUBLIC WORKS
REDSTONE DRIVE SEWER AND WATER IMPROVEMENTS AND
MISCELLANEOUS DRAINAGE IMPROVEMENT PROJECTS

QUARRY POND

FILE NO. 143-4C
CADD NO. R-REDSTONE
SCALE AS NOTED
CONTRACT NO. 201321
JOB NO. 201321
DR. BY WGS
DESIGN BY WGS
CHK. BY DRL
APP. BY PMS

SHEET 7 OF 11