

DEPARTMENT OF PUBLIC WORKS

TOWN OF EAST LONGMEADOW, MASSACHUSETTS



VINELAND AVENUE PUMP STATION

CONTRACTS NO. 1 AND NO. 2

RECORD DRAWINGS

JANUARY 2005

DAVID J. GROMASKI, P.E., SUPERINTENDENT

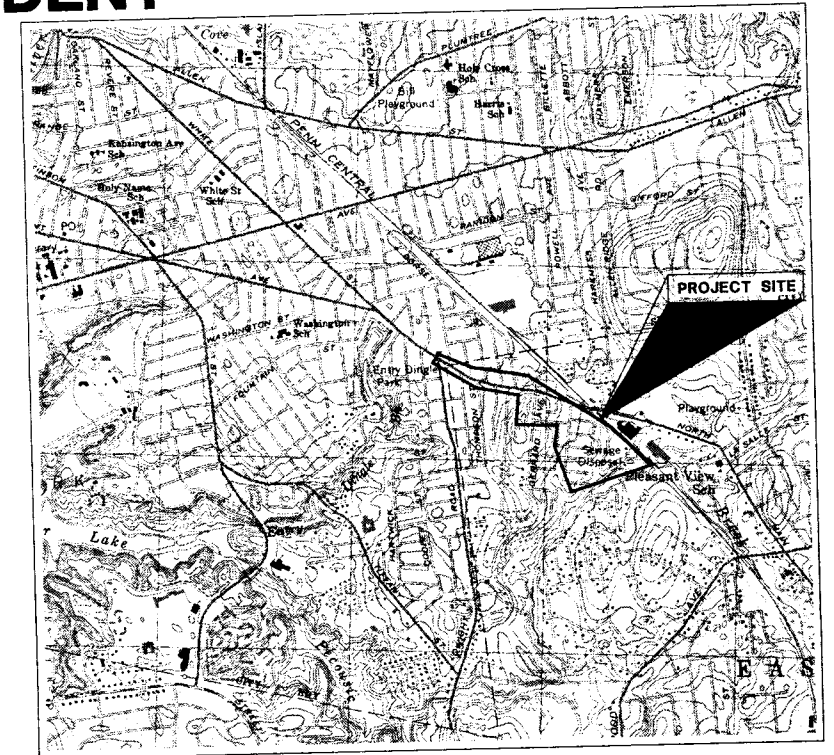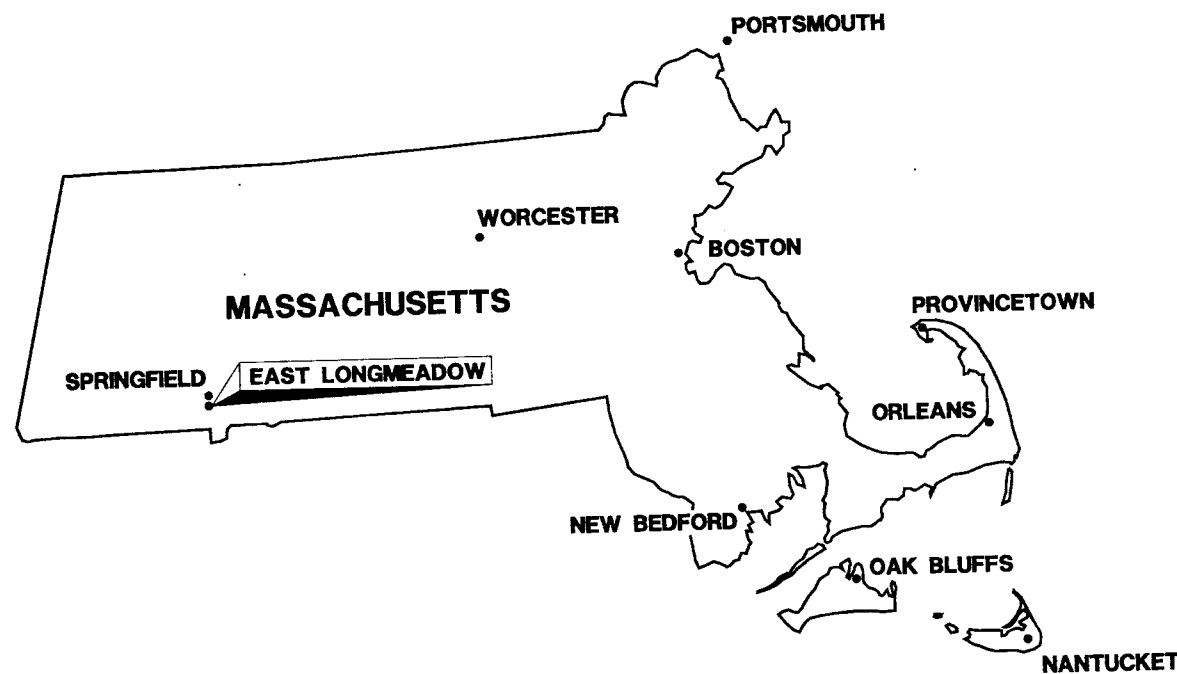

LOCATION PLAN
NTS

THESE RECORD DRAWINGS HAVE BEEN PREPARED, IN PART, ON THE BASIS OF THE INFORMATION COMPILED AND FURNISHED BY OTHERS. THE ENGINEER WILL NOT BE RESPONSIBLE FOR ANY ERRORS OR OMISSIONS WHICH HAVE BEEN INCORPORATED INTO THIS DOCUMENT AS A RESULT.



Wright-Pierce
169 Main Street 700 Plaza Middlesex
Middletown, Connecticut USA 06457
TEL (860) 343-8297 FAX (860) 343-9504

FOR REVIEW DEC 2002

FOR BIDDING FEB 2003

WP PROJECT NO. 7051K