



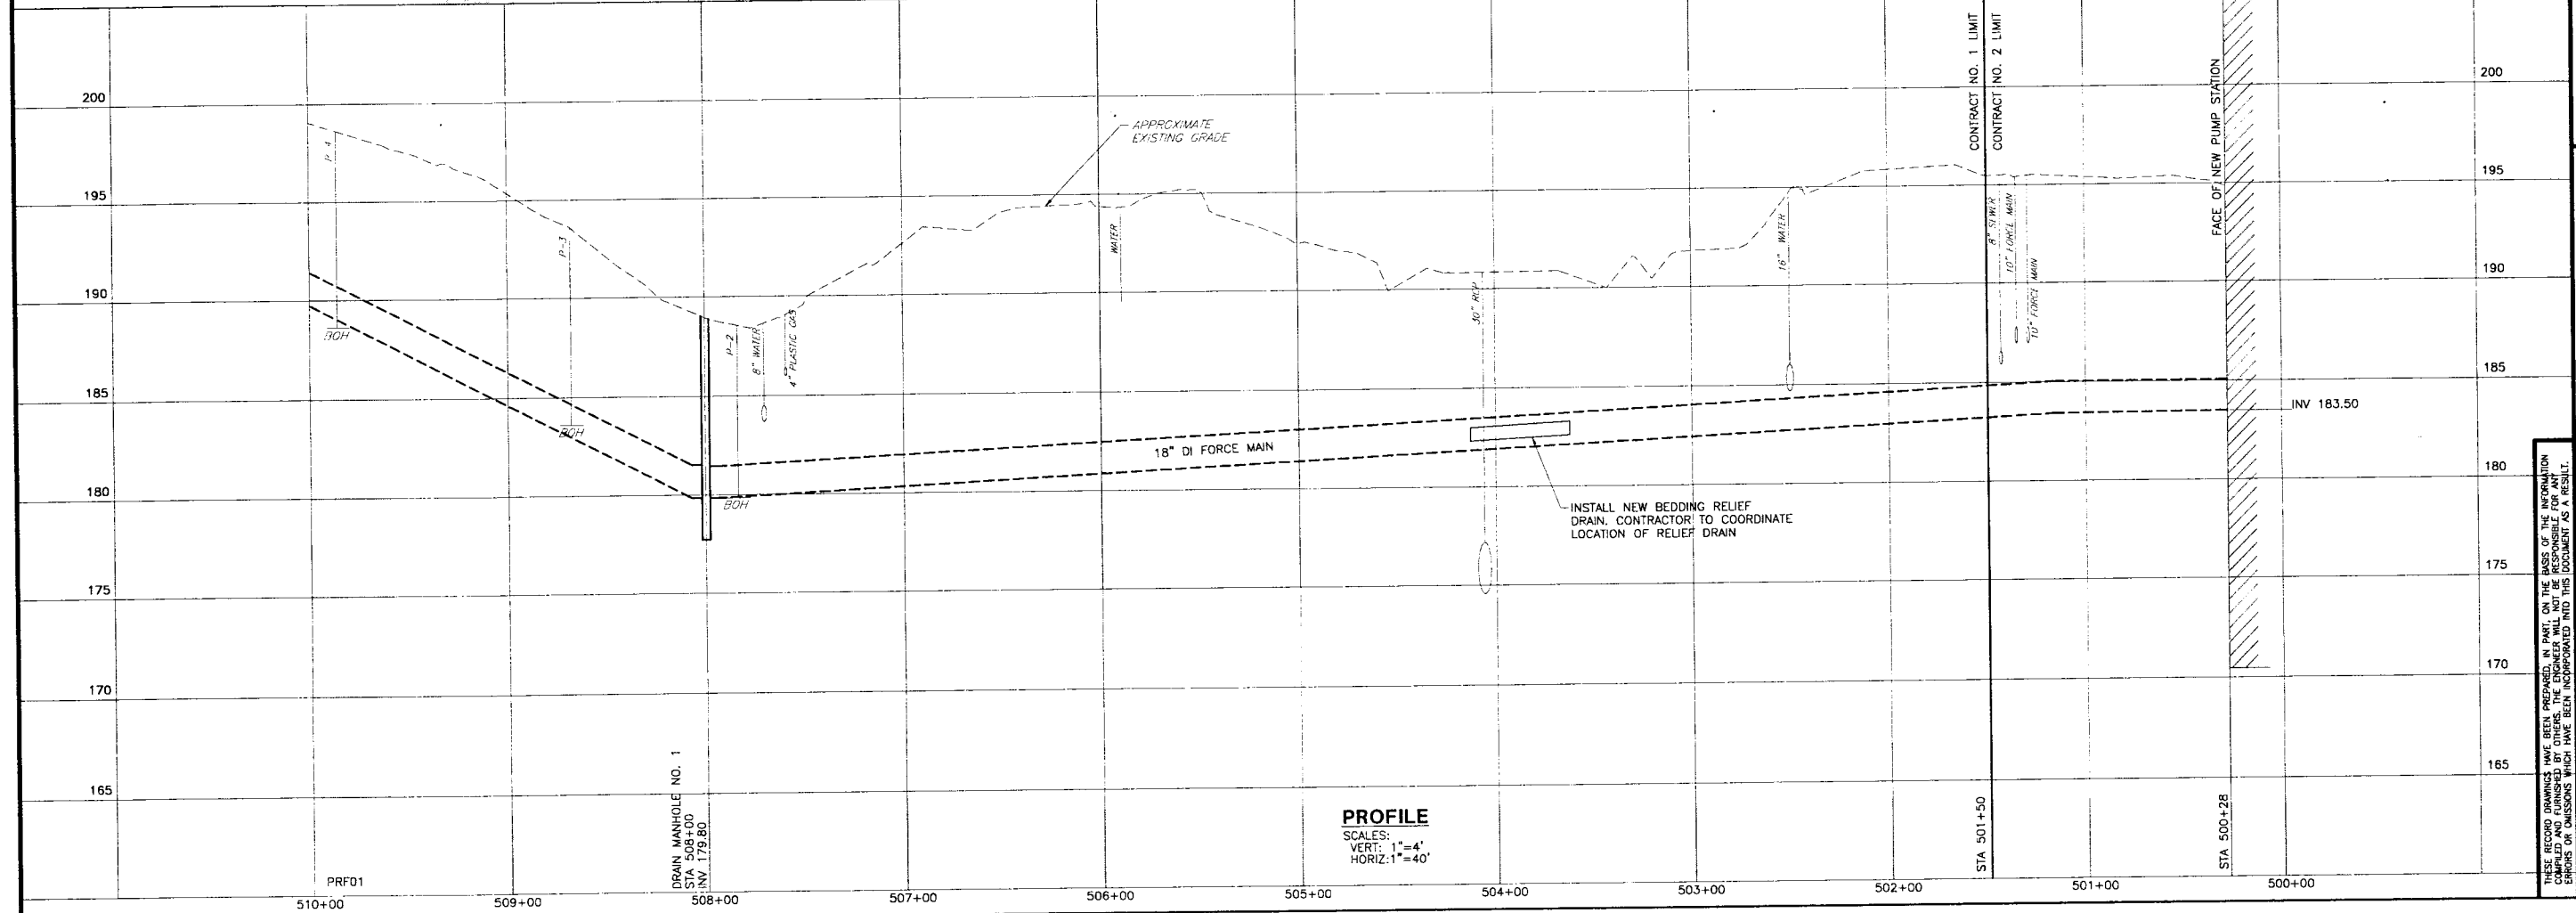

THESE RECORD DRAWINGS HAVE BEEN PREPARED, IN PART, ON THE BASIS OF THE INFORMATION COMPILED AND FURNISHED BY OTHERS. THE ENGINEER WILL NOT BE RESPONSIBLE FOR ANY ERRORS OR OMISSIONS WHICH HAVE BEEN INCORPORATED INTO THIS DOCUMENT AS A RESULT.

DEPARTMENT OF PUBLIC WORKS
TOWN OF EAST LONGMEADOW, MA
VINELAND AVENUE PUMP STATION
CONTRACTS NO. 1 AND NO. 2

**FORCE MAIN
500+28 TO 510+00**

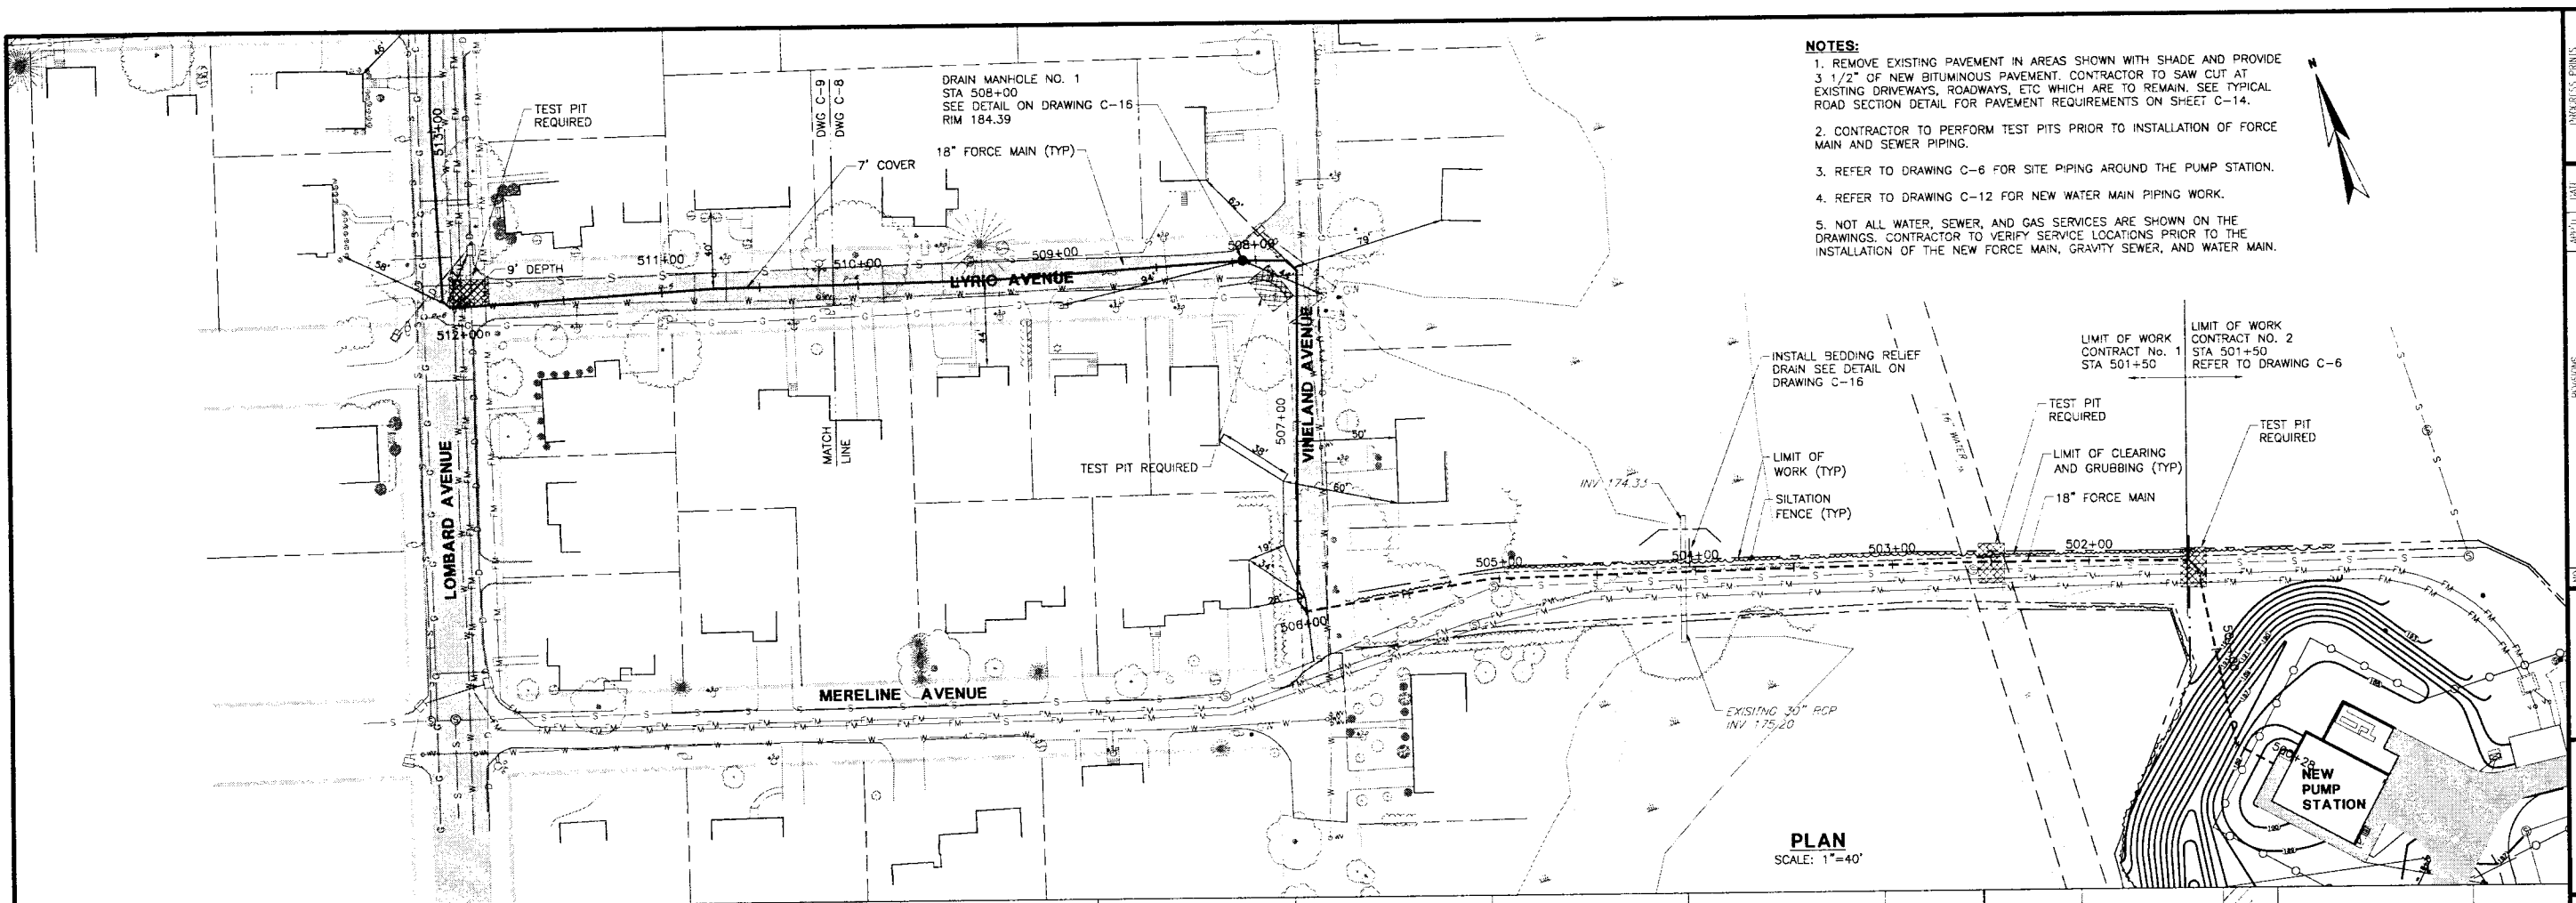

Wright-Pierce
 169 Main Street 700 Plaza Middlesex
 Middletown, Connecticut USA 06457
 TEL (860) 343-9297 FAX (860) 343-9504

DOWN BY SJM	NO	REVISIONS	DATE	ISSUED FOR REVIEW	12-02
CHECKED BY SCH	A			ISSUED FOR BIDDING	2-03
DATE 12-19-02	A				
APPROVED BY SCH	A			SALE LOCATION	
DATE 1-31-03	A			LOT NUMBER ON	
BOOK NO	A			PLANNING	
PROJECT NO 7051K	A				
SCALE AS NOTED	A				